


T.2S. R.3E. W.M.

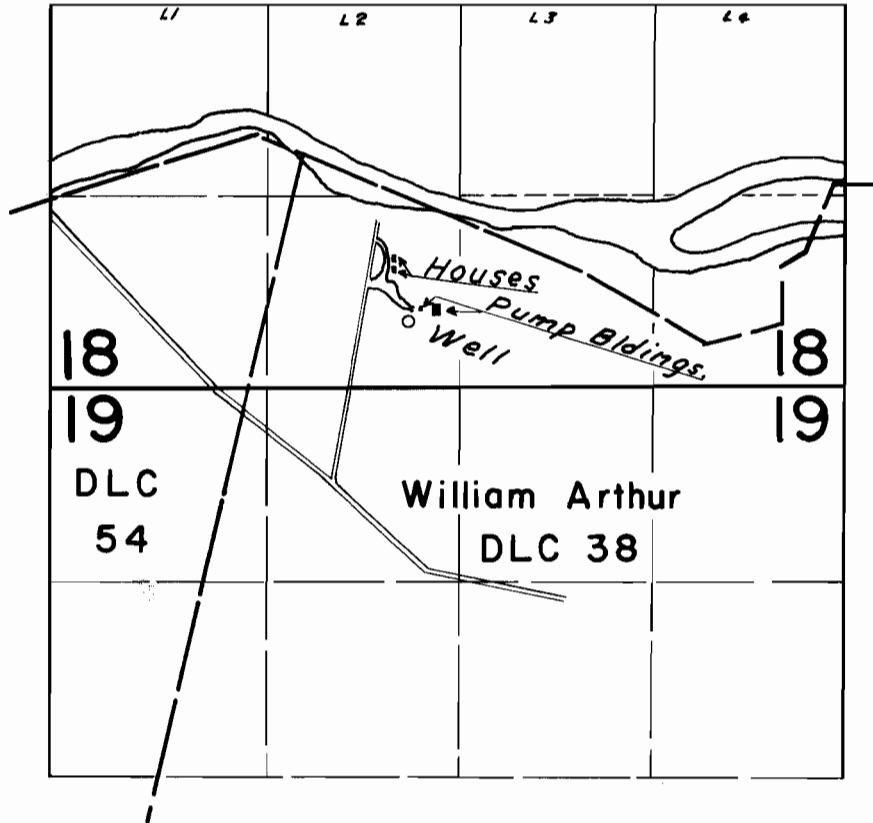

FINAL PROOF SURVEY
UNDER

Application No. G-2707. Permit No. G-2515
IN NAME OF

EL PASO NATURAL GAS COMPANY

Surveyed August 12, 1964., by *C.J. Gardner*