


T.2S. R.2E. W.M.

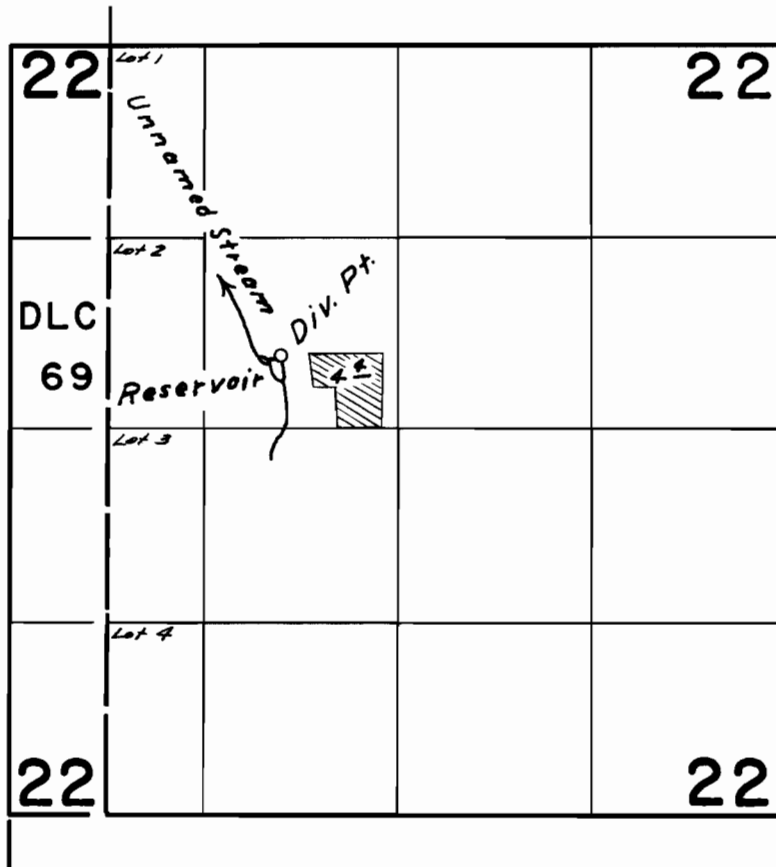

FINAL PROOF SURVEY
UNDER

R-32665 R-2189
Application No. 32666 Permit No. 25795
IN NAME OF

FRANKLIN L. ELLSWORTH

Surveyed August 12, 1964, by *C.J. Gardner*