


T.5S. R.1E. W.M.

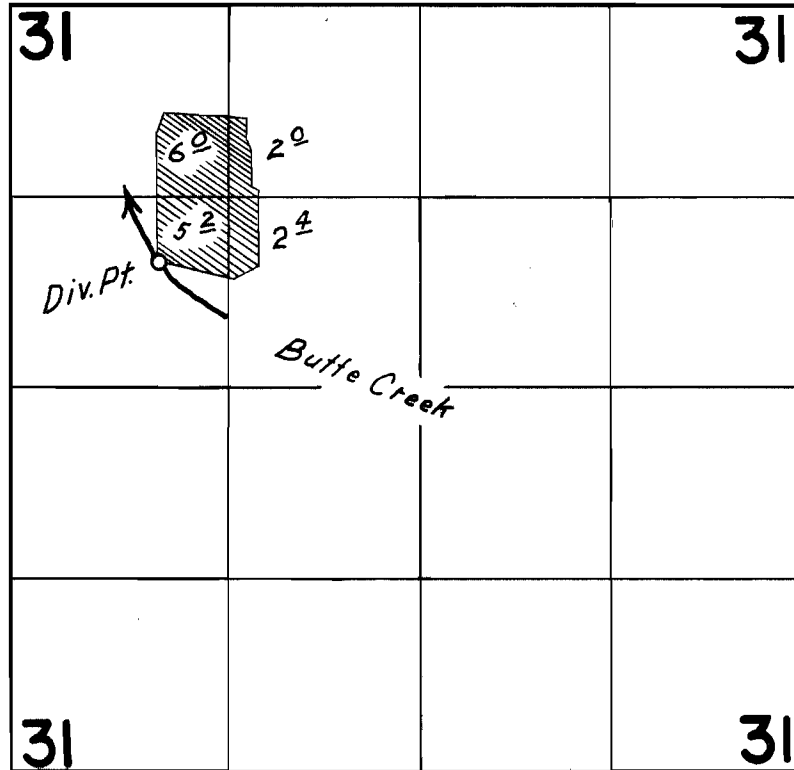

FINAL PROOF SURVEY
UNDER

Application No. 33619 Permit No. 26584
IN NAME OF

R. W. BALDWIN

Surveyed July 20, 1964, by C. J. Gardner