


T.3S. R.2E. W.M.

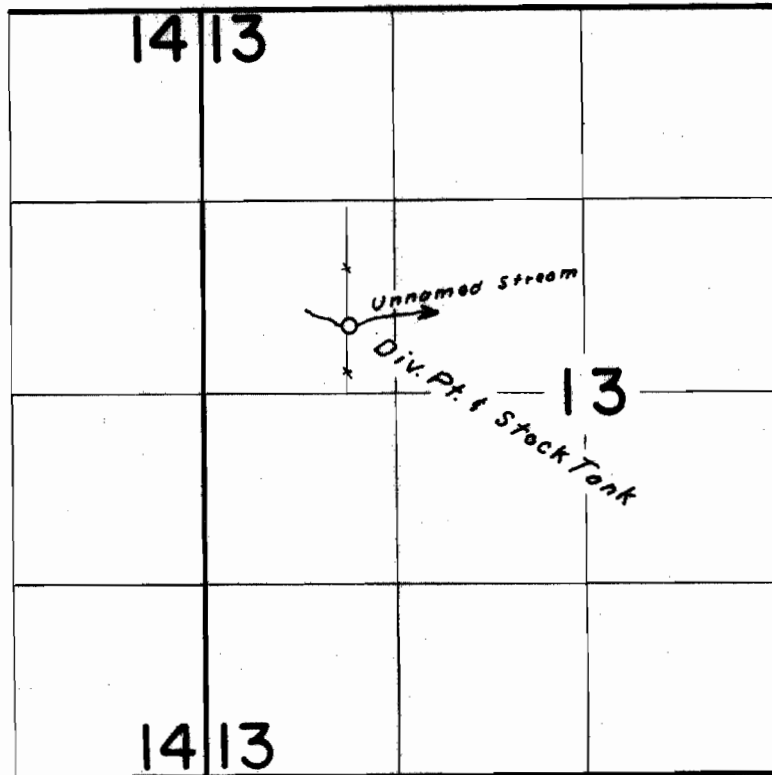

FINAL PROOF SURVEY
UNDER

Application No. 34403 Permit No. 27027
IN NAME OF

VERLIN L. ATWOOD

Surveyed August 10, 1964, by C. J. Gardner