T.4S.R.1E.W.M.

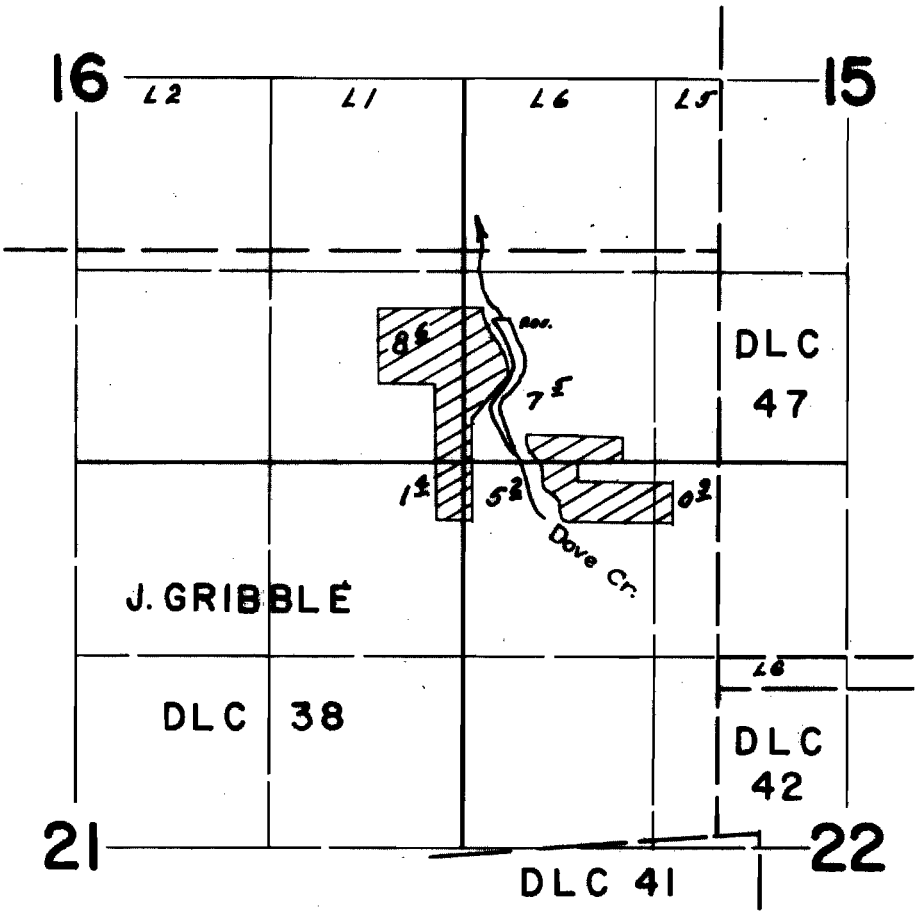

FINAL PROOF SURVEY
UNDER

R-34482 R-2558
Application No. 34483 Permit No. 27080
IN NAME OF

HOWARD J. & CHESTER H. SMITH

Surveyed April 18 1963, by
July 3, 1964 C. Gardner

1964-M
1963-J