


T.4S.R.1E.W.M.

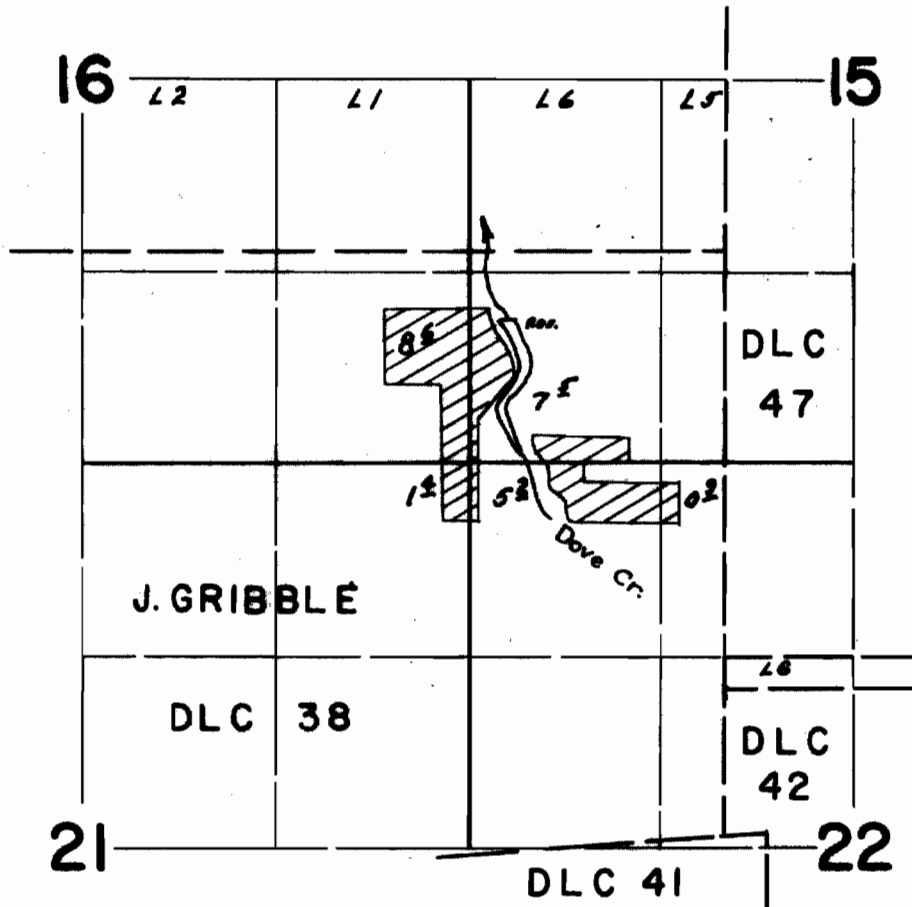

FINAL PROOF SURVEY UNDER

R-34482 R-2558
Application No. 34483. Permit No. 27080.
IN NAME OF

HOWARD J. & CHESTER H. SMITH

Surveyed April 18 1963, by *C. Gardner*
July 3, 1964 C. Gardner