


T.2S.R.3E.W.M.

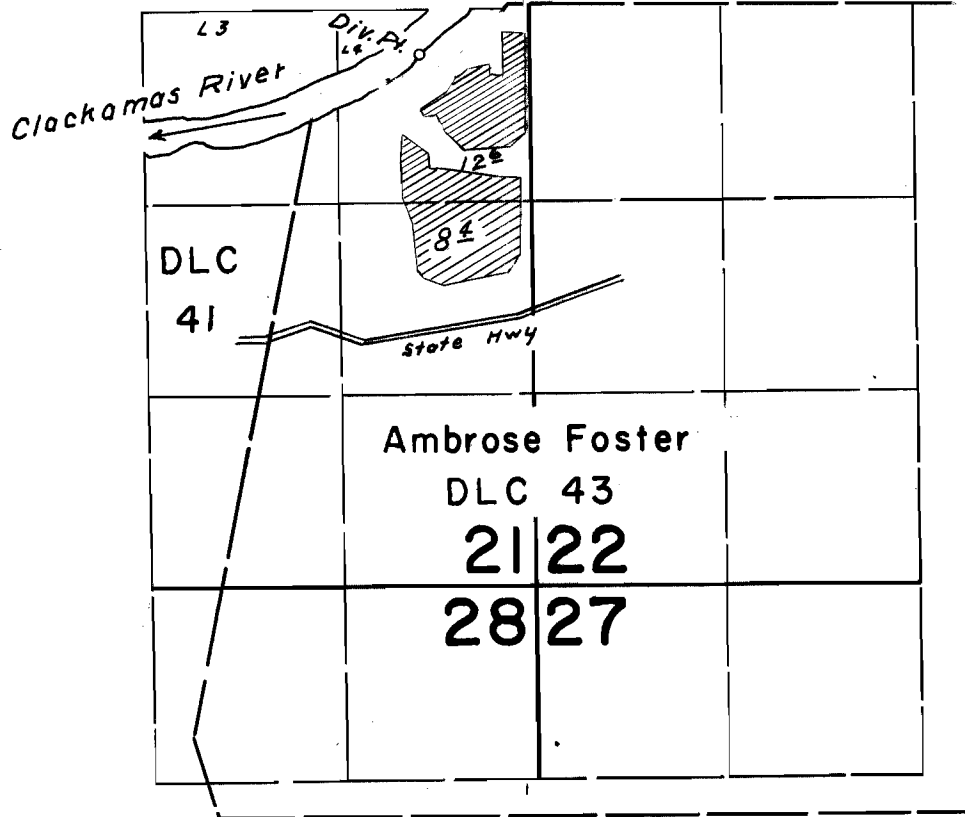

**FINAL PROOF SURVEY**  
UNDER

Application No. 37891    Permit No. 28236  
IN NAME OF

RAY JENSEN

Surveyed August 27, 1964., by *C.J. Gardner*