


T. 4S. R. 1W. & E. W.M.

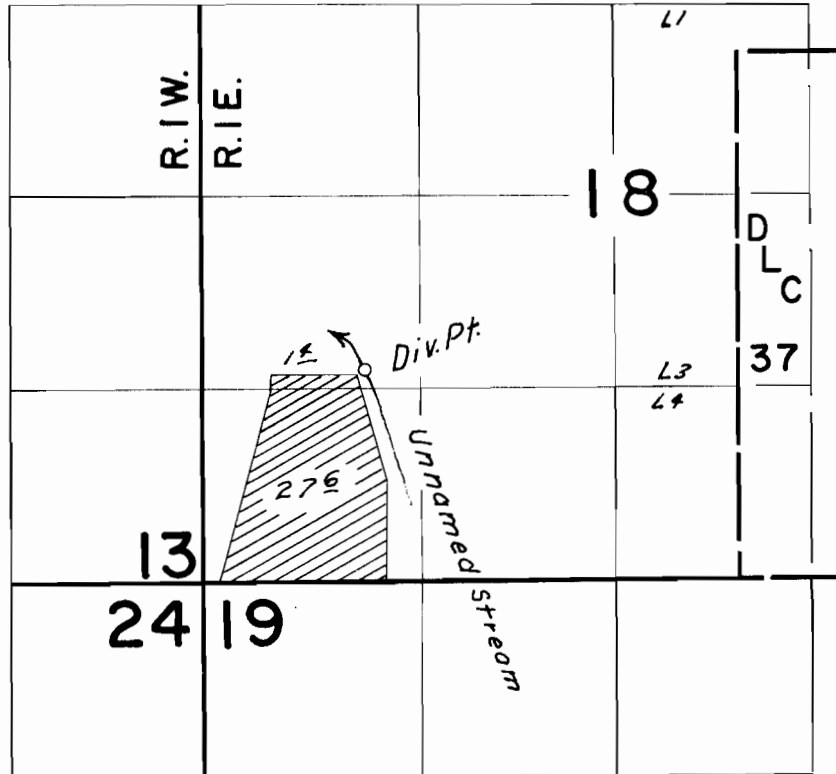

FINAL PROOF SURVEY UNDER

Application No. 38238 Permit No. 28485
IN NAME OF

LEO F. SCHMITT

Surveyed Sept. 1, 1964, by *C. J. Gardner*