


T.4S. R.2E. W.M.

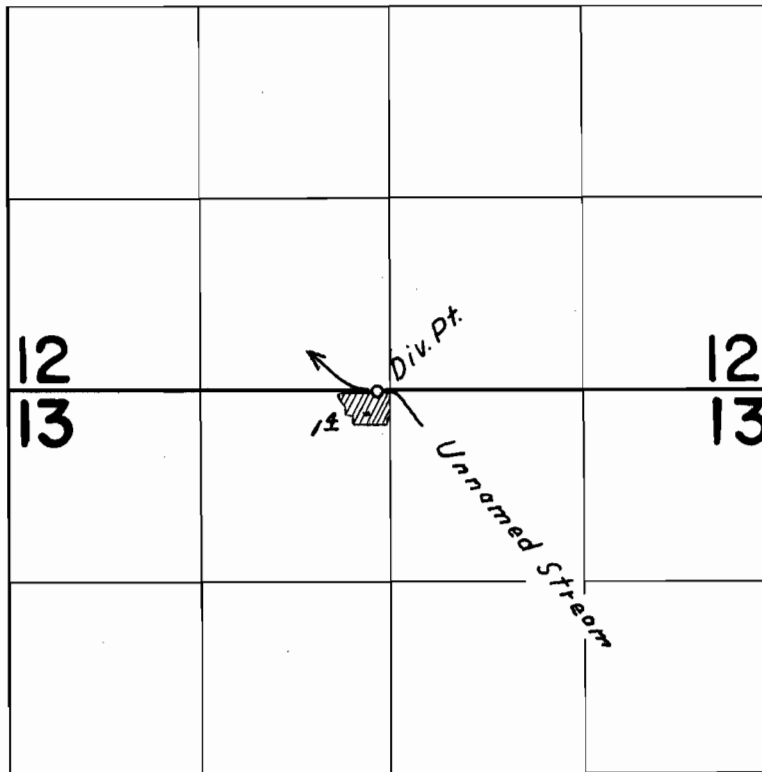

FINAL PROOF SURVEY
UNDER

Application No. 38802 Permit No. 28941
IN NAME OF

BURKE BUNNELL

Surveyed July 23, 1964, by C. J. Gardner