


T.1&2S. R.3E. W.M.

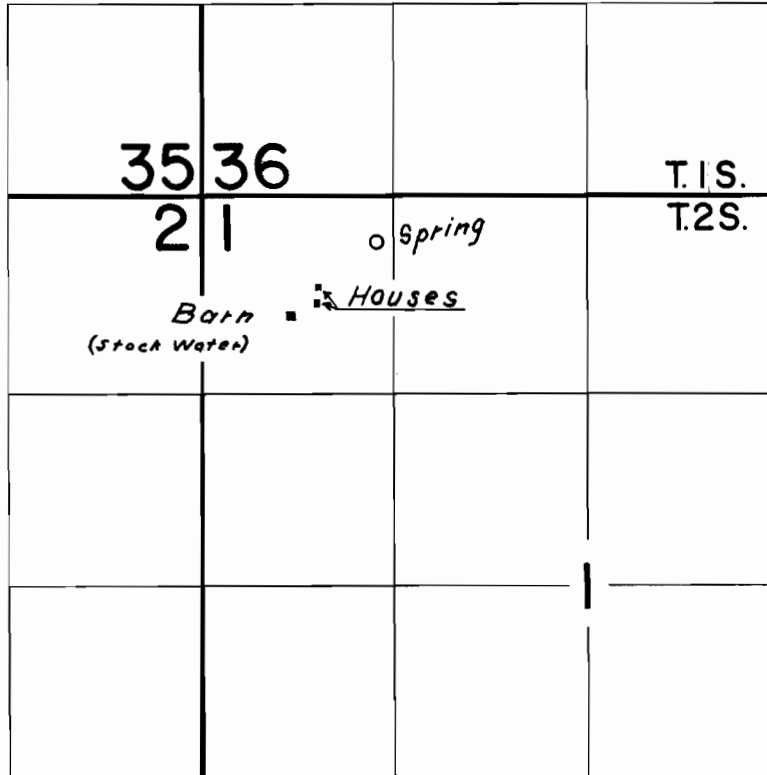

FINAL PROOF SURVEY
UNDER

Application No. 39089 Permit No. 29101
IN NAME OF

ROY F. POLIVKA

Surveyed August 13, 1964., by *C.J. Gardner*