


T.16S.R.18E.W.M.

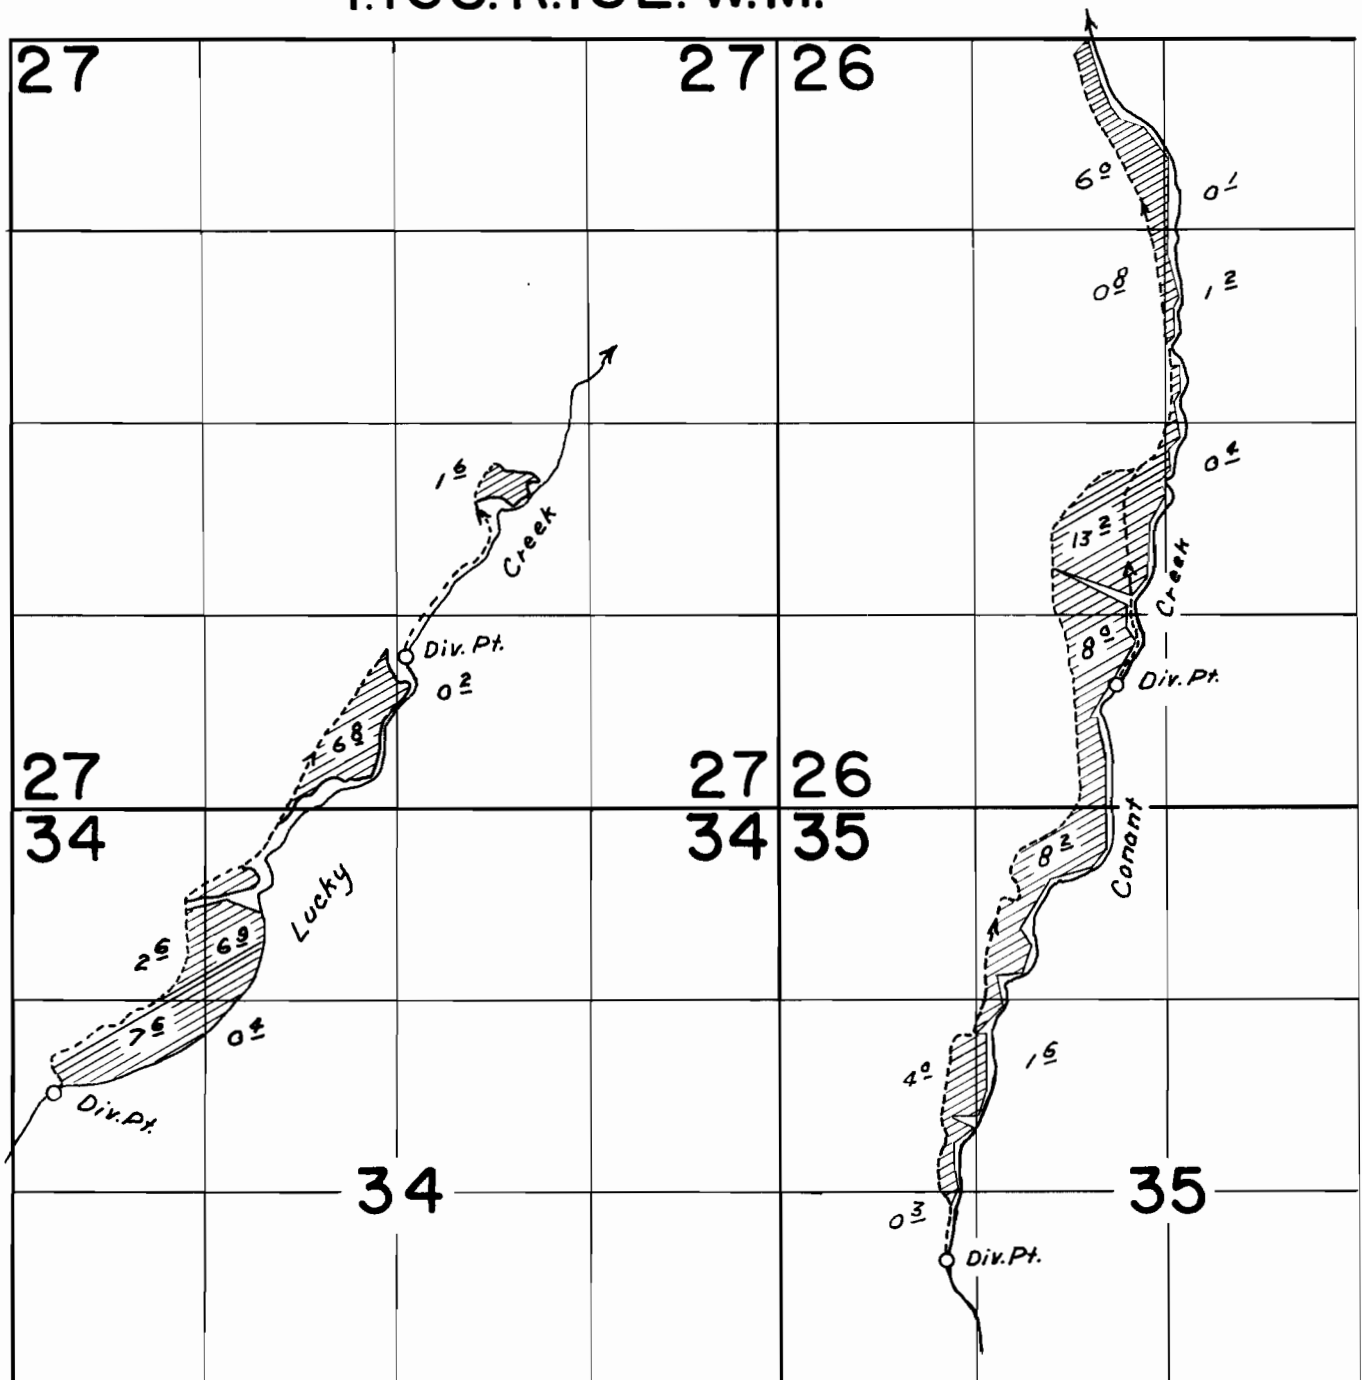

FINAL PROOF SURVEY
UNDER

Application No. 28552 Permit No. 22333
IN NAME OF

JOHN BEOLETTO

Surveyed Oct. 1, 1964, by C.J. Gardner