


T.14S. R.14E. W.M.

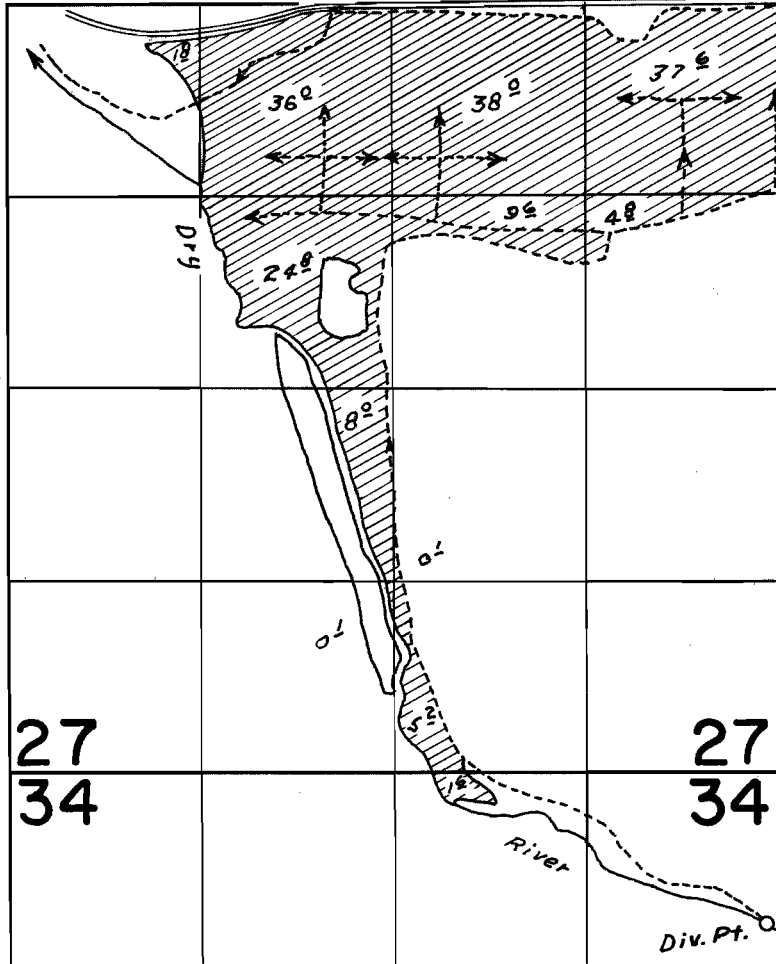

FINAL PROOF SURVEY
UNDER

Application No. 31832 Permit No. 25467

IN NAME OF

GEORGE T. HIGGINS ET UX

Surveyed Sept. 29, 1964., by *C.J. Gardner*