


T.24S. R.5W. W.M.

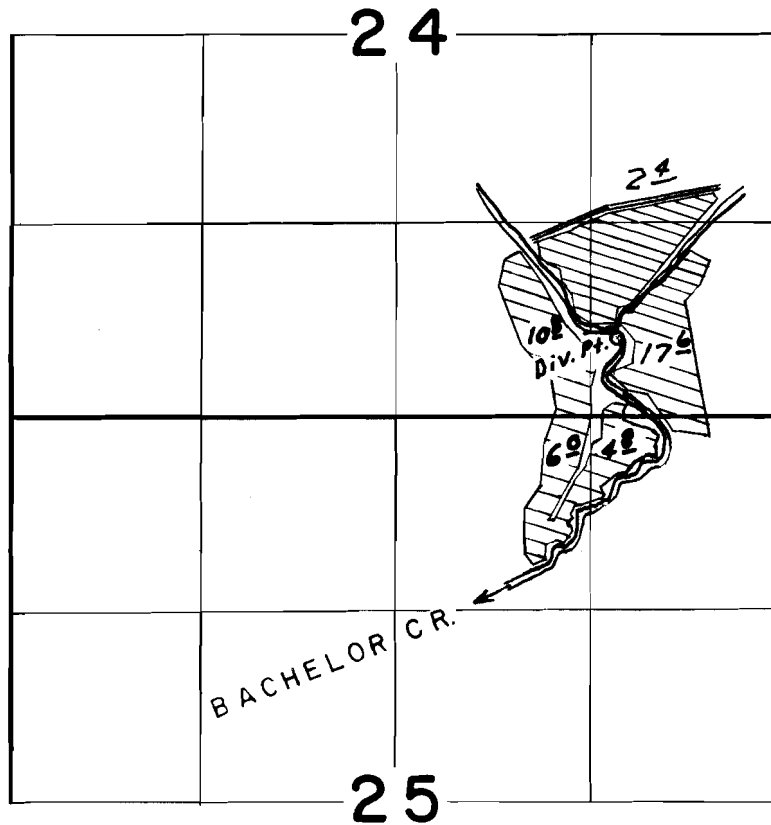

FINAL PROOF SURVEY
UNDER

Application No. 32282... Permit No. 25459.
IN NAME OF

GARY ROBERSON

Surveyed July 9, 1964, by *C. Gardner*