


T.25 S. R.4 W. W.M.

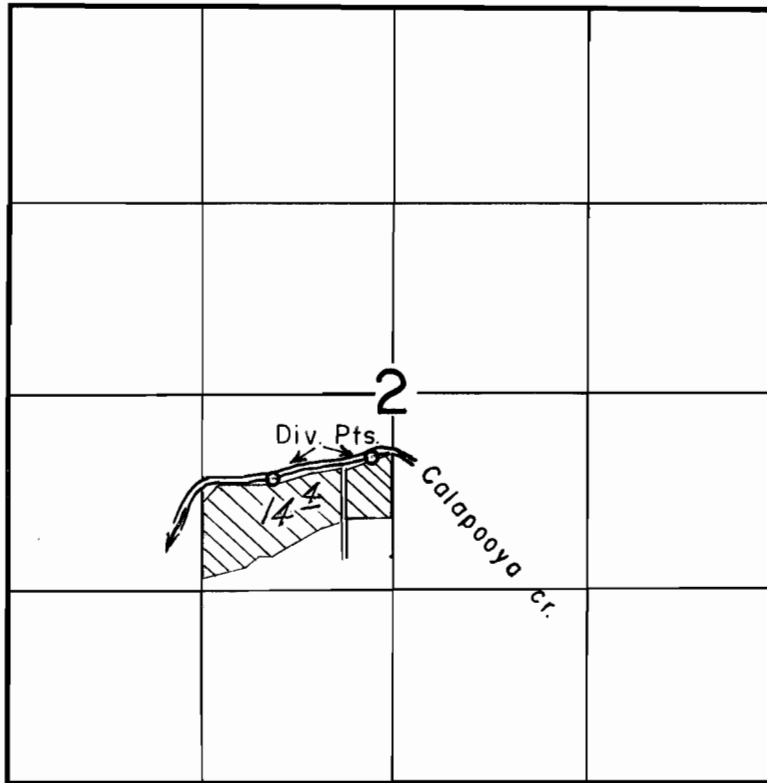

**FINAL PROOF SURVEY**  
UNDER

Application No. 33770 Permit No. 26662

IN NAME OF

RICHARD L. CARR

Surveyed July 6 1964, by C.J. Gardner