


T.30S. R.2W. W.M.

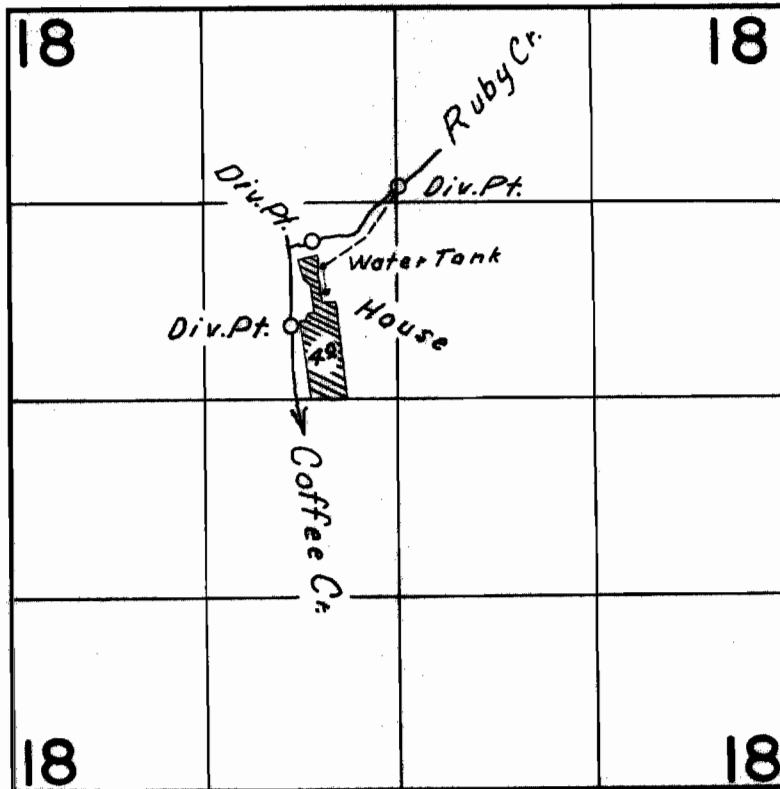

FINAL PROOF SURVEY
UNDER

Application No. 34076 Permit No. 26851
IN NAME OF

CHARLIE DAVID GARREN

Surveyed Aug. 5, 1964, by C. J. Gardner