


T.26S.R.5W.W.M.

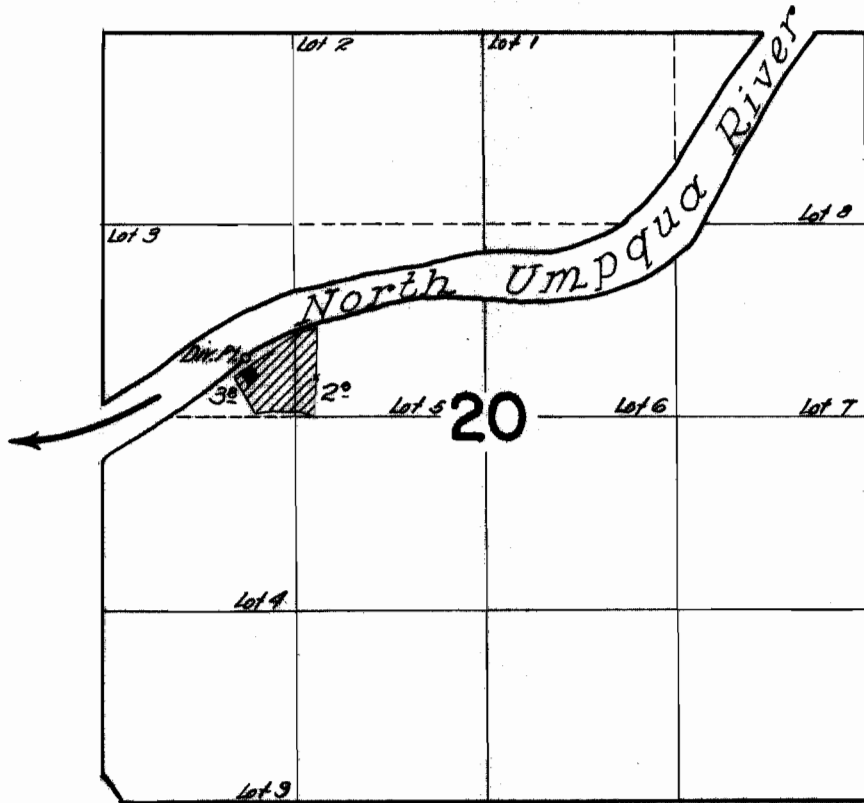

FINAL PROOF SURVEY UNDER

Application No. 34038... Permit No. 26872...
IN NAME OF

HJALMER A. & MARY J. JOHNSON

Surveyed June 10, 1963, by T. Lauer.....