


T.29S. R.5W. W.M.

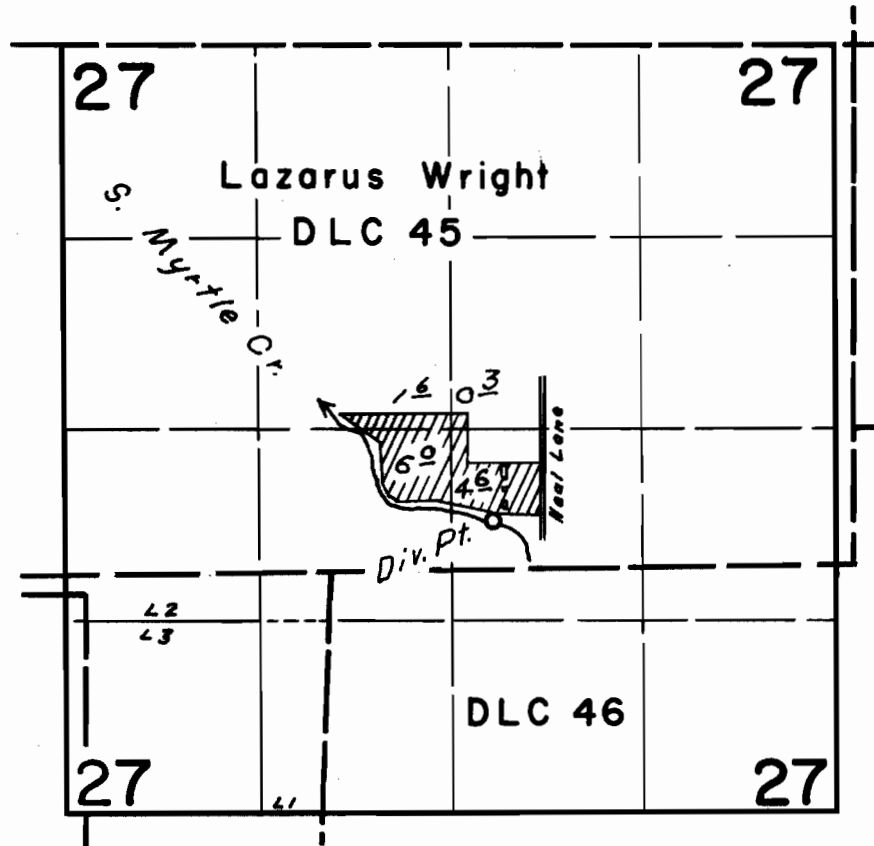

**FINAL PROOF SURVEY**  
UNDER

Application No. 34806 Permit No. 27340  
IN NAME OF

**CHESTER C. and JOYCE A. CHAMBERLAIN**

Surveyed Aug. 4, 1964, by C. J. Gardner.