


T.24S. R.7W. W.M.

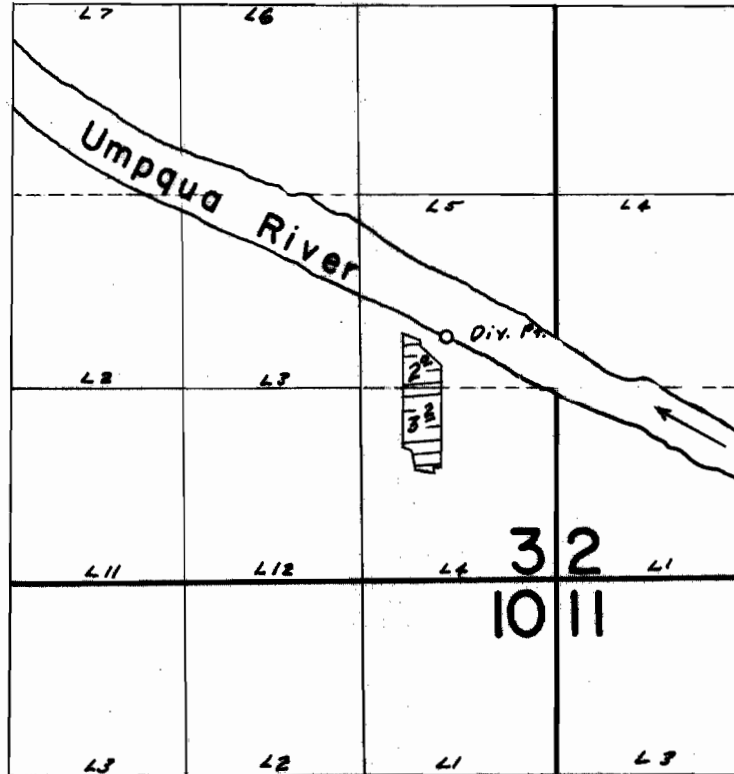

FINAL PROOF SURVEY
UNDER

Application No. 35057... Permit No. 27447..
IN NAME OF

HOWARD A. LEONARD

Surveyed July 9, 1964, by C. J. Gardner