


T.24S. R.7W. W.M.

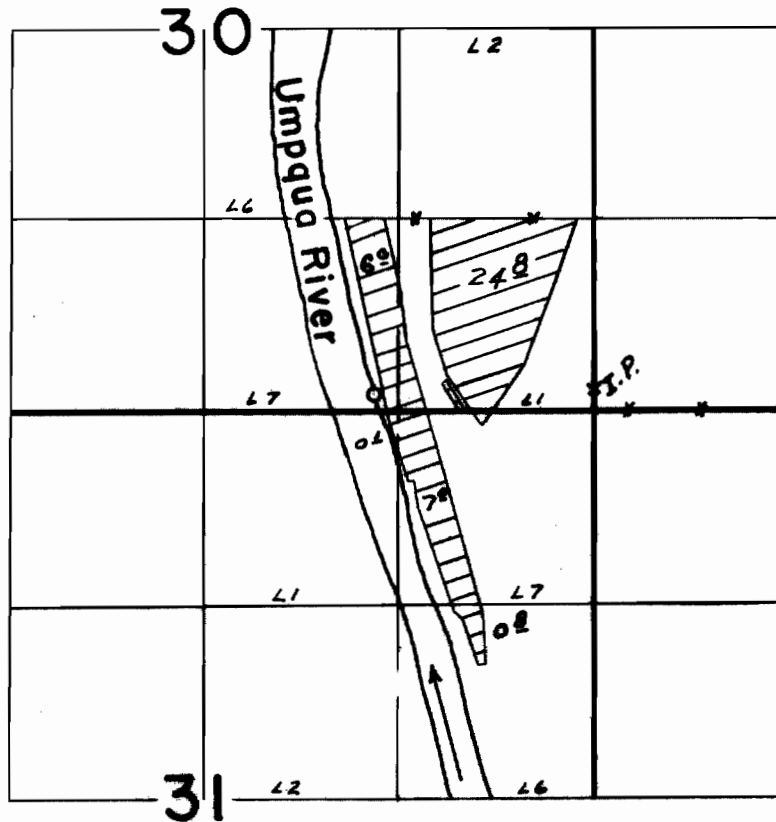

**FINAL PROOF SURVEY**  
UNDER

Application No. 35817..... Permit No. 27552..  
IN NAME OF

**C. W. KEENE**

Surveyed July 13, 1964, by *C. J. Gardner*