


T.24S. R.7W. W.M.

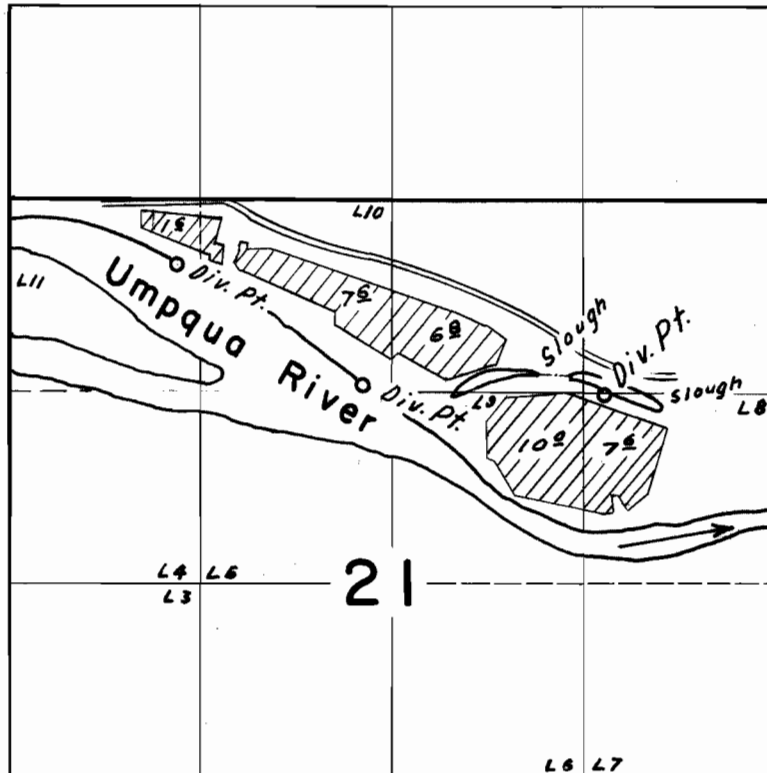


FINAL PROOF SURVEY
UNDER

Application No. 37511 Permit No. 27957
IN NAME OF

A. O. KOBBE

Surveyed July 31, 1964, by C. J. Gardner

T. 24 S. R. 7 W. W. M.

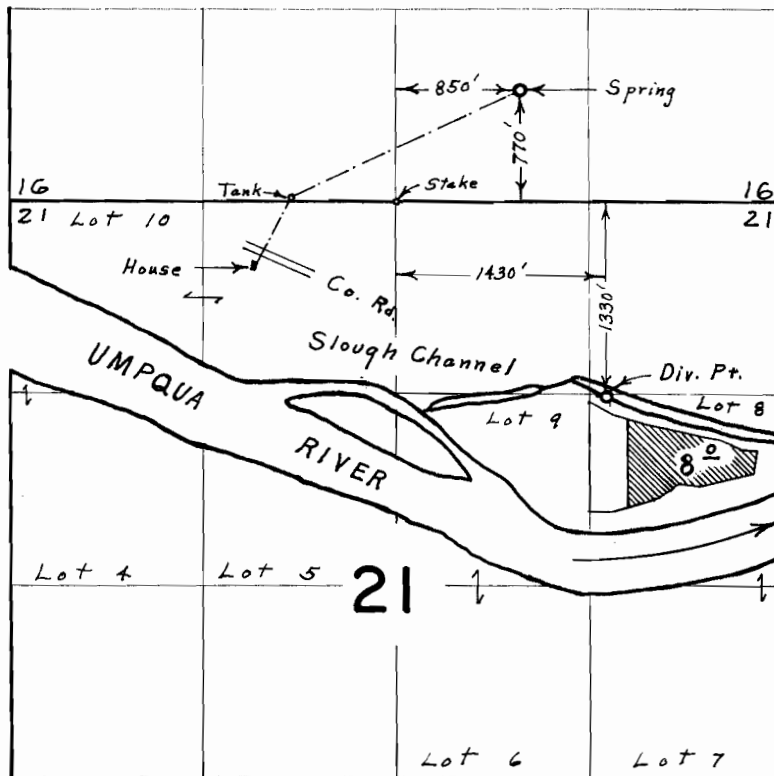

FINAL PROOF SURVEY
UNDER

Application No. 41721 Permit No. 31149
IN NAME OF
A. O. KOBBE

Surveyed June 15, 1967, by L. E. Gould