


T.28S. R.6W. W.M.

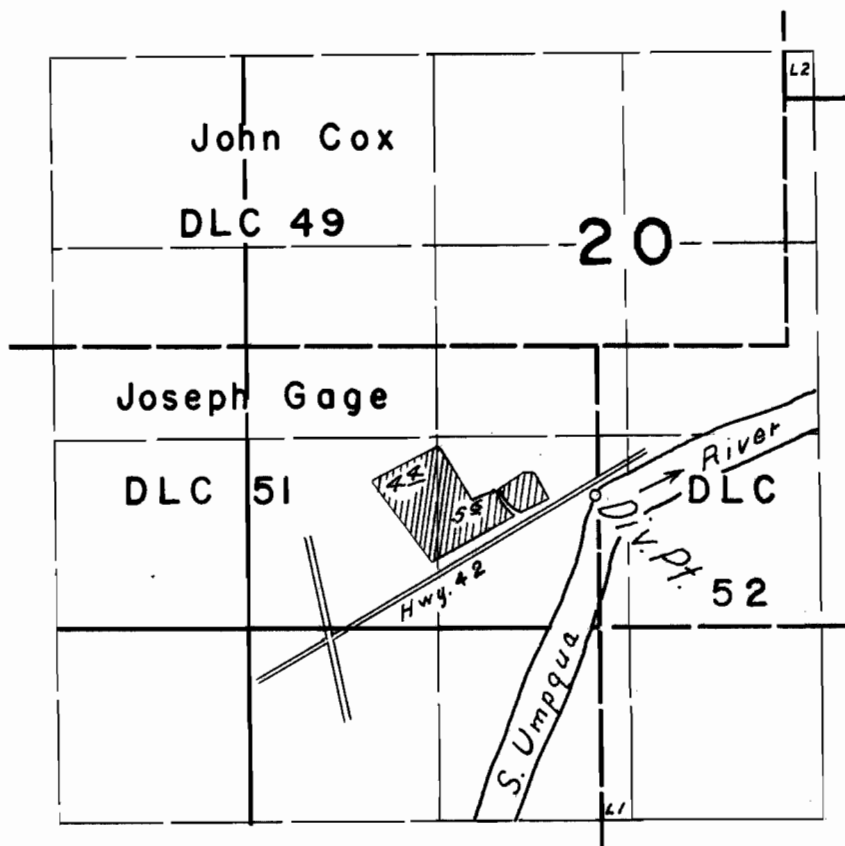

FINAL PROOF SURVEY
UNDER

Application No. 37785 Permit No. 28147
IN NAME OF

SCHOOL DISTRICT NO. 116

Surveyed August 3, 1964, by C. J. Gardner