


T.28S. R.7W. W.M.

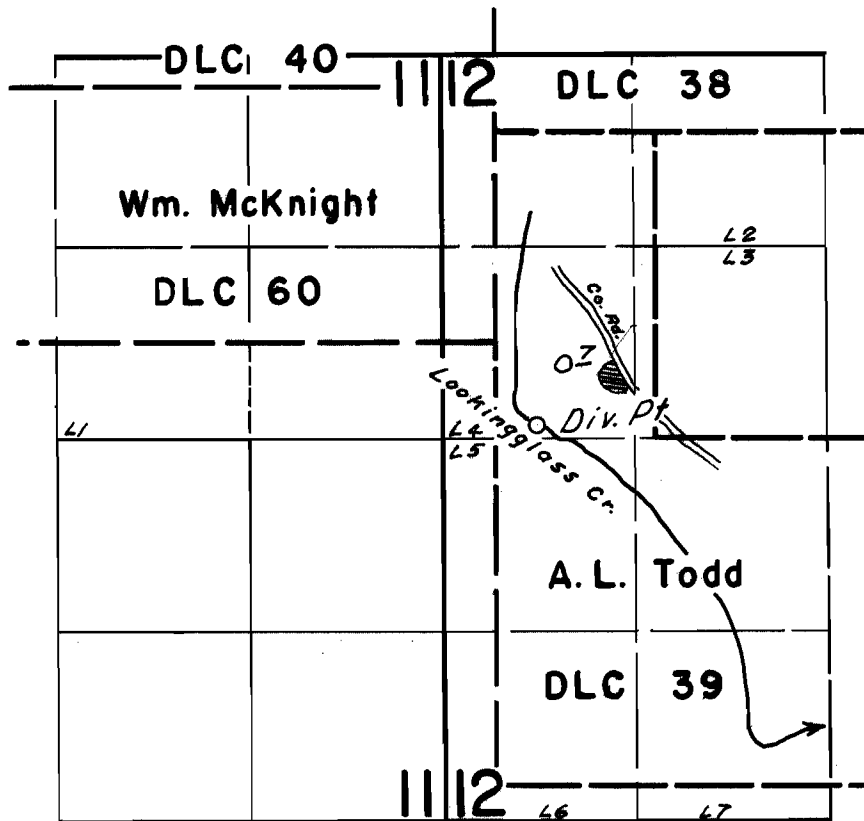

**FINAL PROOF SURVEY**  
UNDER

Application No. 38046 Permit No. 28348  
IN NAME OF

**DON OLLIVANT**

Surveyed Aug. 3, 1964, by C. J. Gardner