


T.26S. R.6W. W.M.

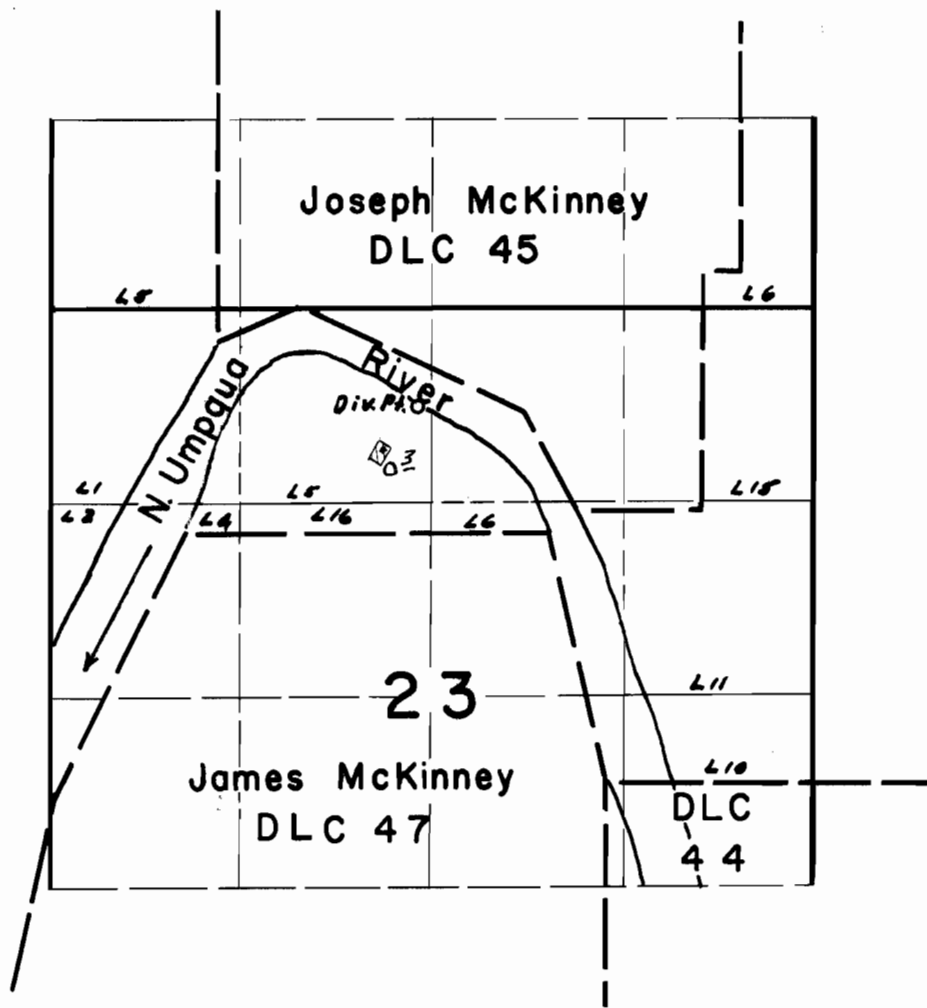

FINAL PROOF SURVEY
UNDER

Application No. 38016... Permit No. 28376...
IN NAME OF
WILLIAM M. & EUNICE S. BYRON

Surveyed July 14, 1964, by *C. J. Gardner*