


T.30S. R.4W. W.M.

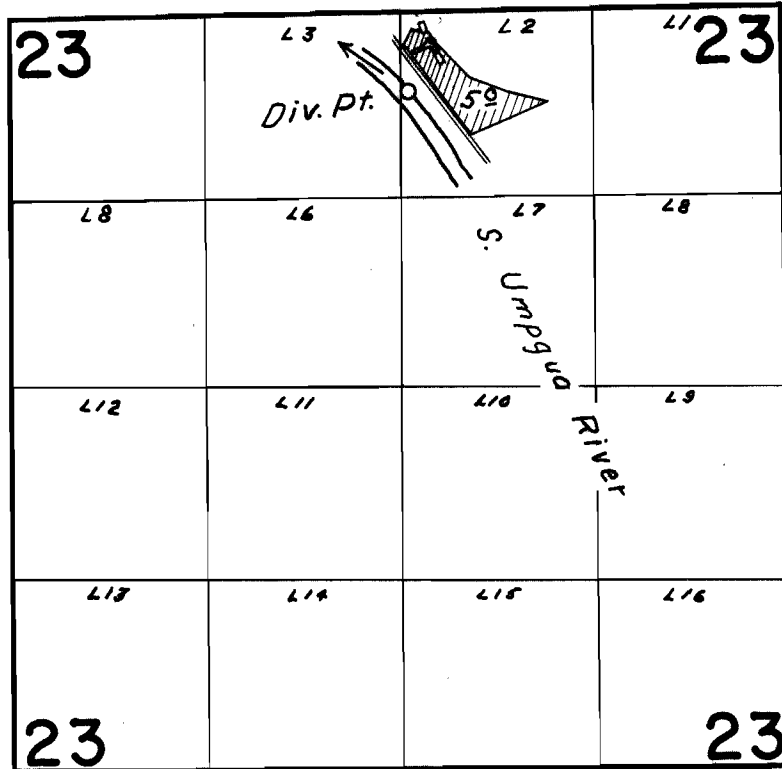

FINAL PROOF SURVEY
UNDER

Application No. 38173 Permit No. 28453
IN NAME OF

A. A. SCHAFFER & BEATRICE SCHAFFER

Surveyed Aug. 5, 1964, by C. J. Gardner