


T.27S. R.5W. W.M.

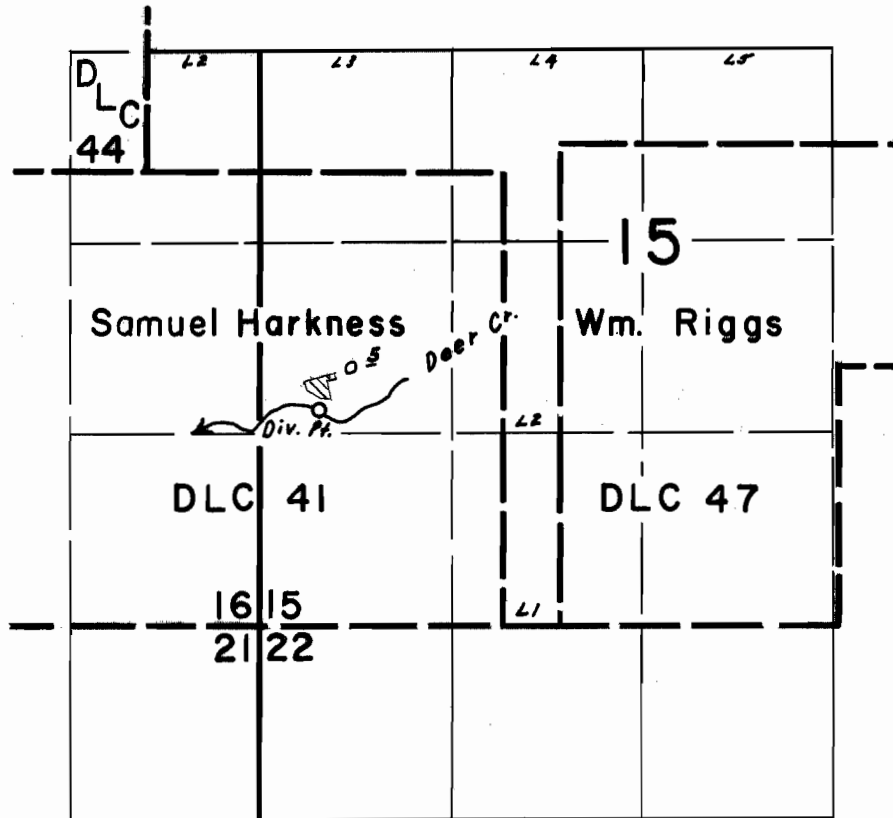

**FINAL PROOF SURVEY**  
UNDER

Application No. 38477 Permit No. 28652

IN NAME OF

RICHARD J. & EVA M. SWANSON

Surveyed July 15, 1964, by C. J. Gardner