


T.29S. R.5W. W.M.

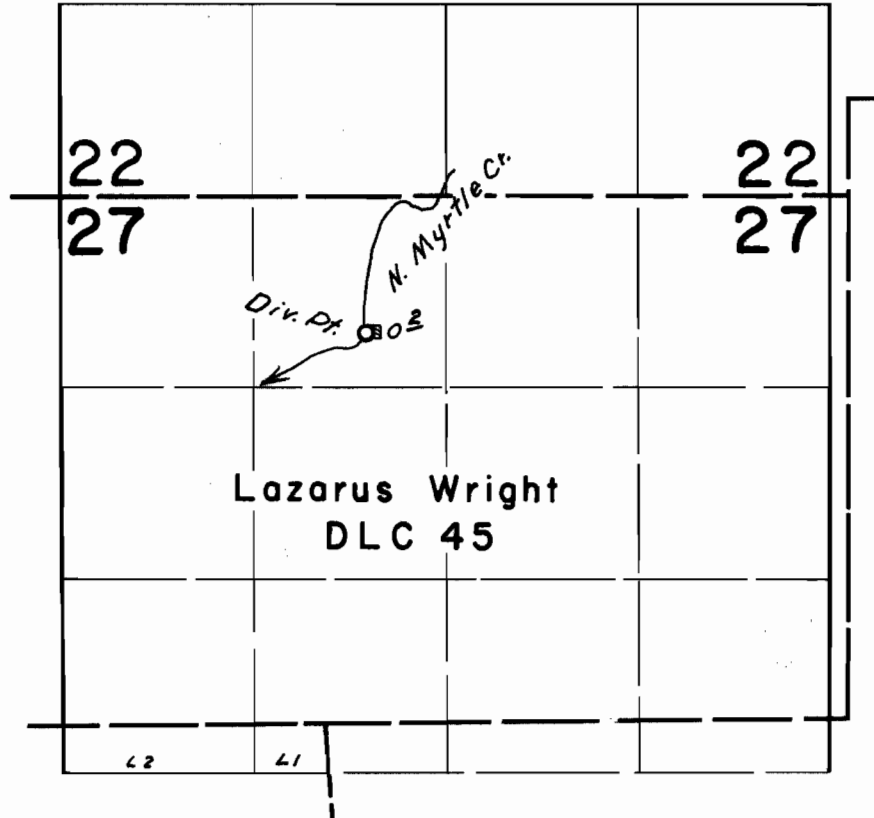

FINAL PROOF SURVEY
UNDER

Application No. 38661 Permit No. 28770
IN NAME OF

OLIVER L. SPITZER and BEATRICE A. SPITZER

Surveyed Aug. 5, 1964, by C. J. Gardner