


T.24S. R.7W.W.M.

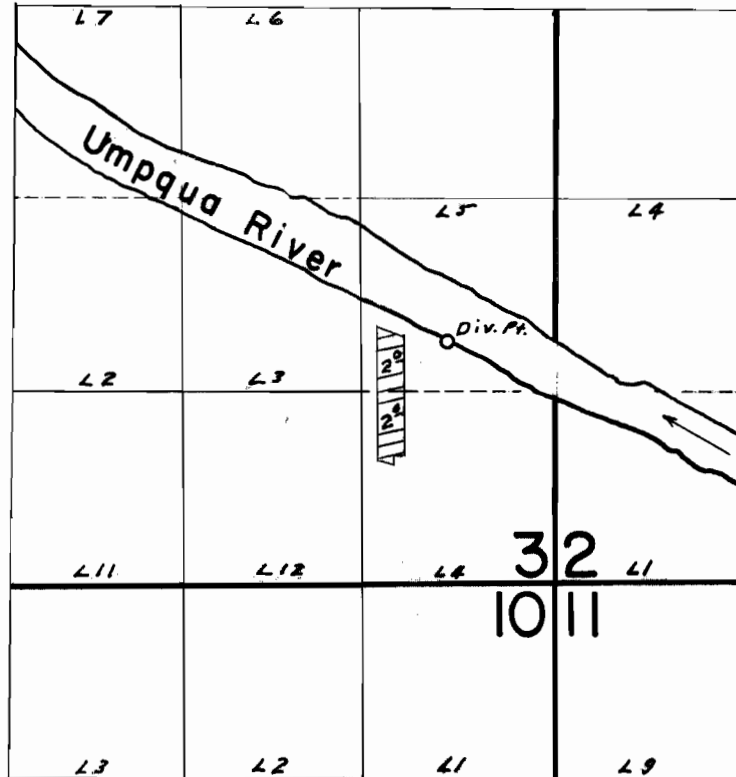

FINAL PROOF SURVEY
UNDER

Application No. 38663 Permit No. 28772
IN NAME OF

HOWARD A. LEONARD

Surveyed July 9, 1964, by C. J. Gardner