


T.25S. R.7W. W.M.

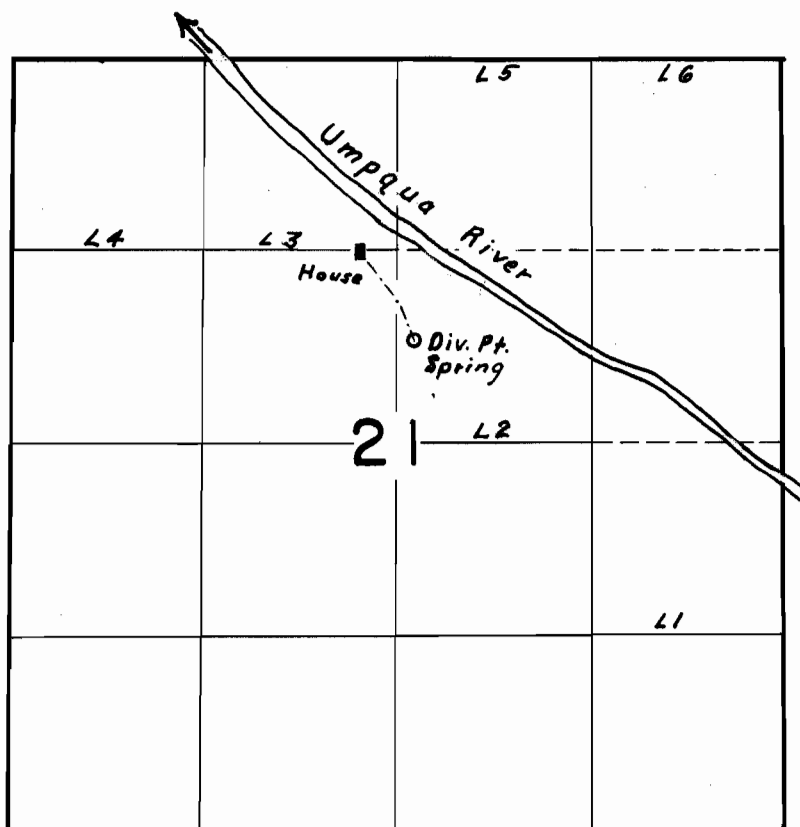

FINAL PROOF SURVEY
UNDER

Application No. 38751 Permit No. 28841
IN NAME OF

ROBERT R. or HELEN H. CAMPBELL

Surveyed July 7, 1964 by C. J. Gardner