


T.28S. R.7W. W.M.

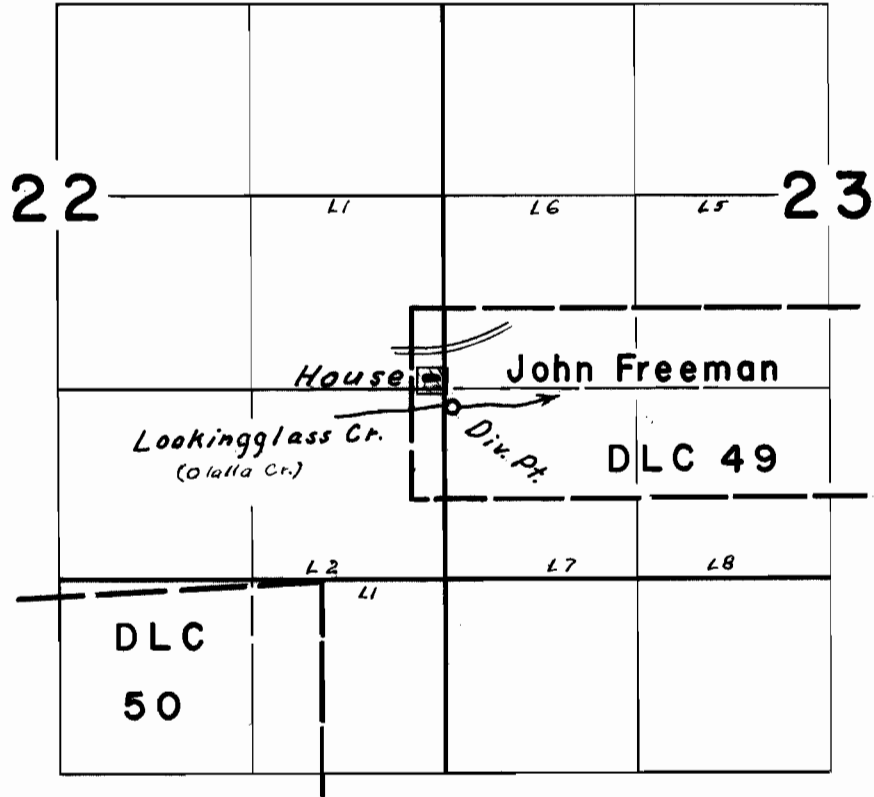

FINAL PROOF SURVEY
UNDER

Application No. 38816 Permit No. 28886
IN NAME OF

CLARENCE W. REDENIUS

Surveyed July 30, 1964, by *C. J. Gardner*