


T.29S. R.6W. W.M.

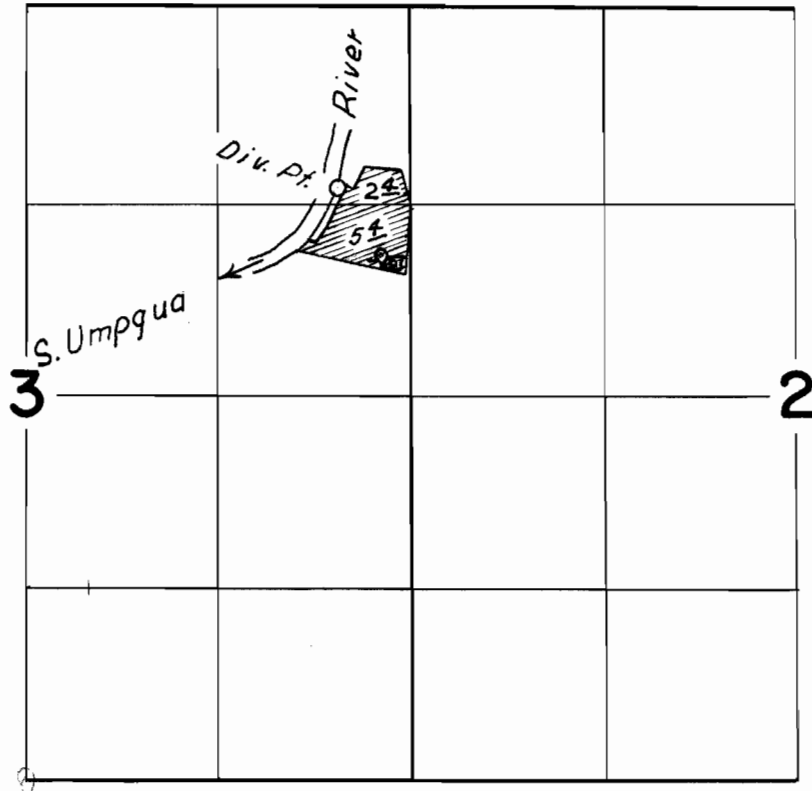

**FINAL PROOF SURVEY**  
UNDER

Application No. 38794 Permit No. 28939  
IN NAME OF

GERALD R. WHITSON

Surveyed Aug. 4, 1964, by C.J. Gardner