


T.27S. R.6W. W.M.

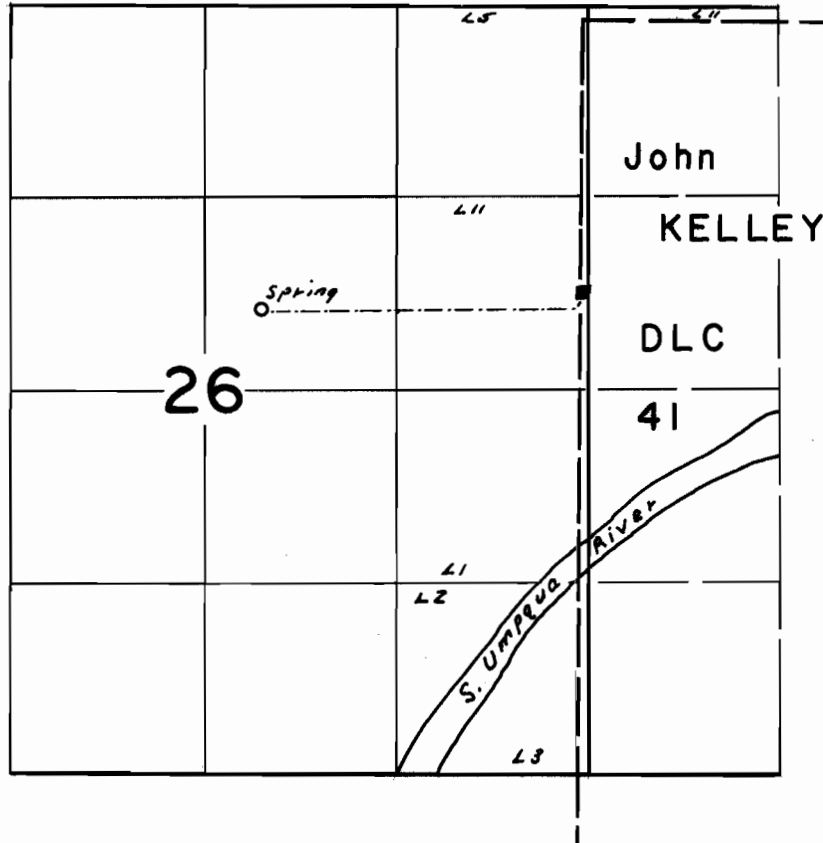

**FINAL PROOF SURVEY**  
UNDER

Application No. 38849 Permit No. 28997  
IN NAME OF

**BRUCE M. DODGE**

Surveyed July 15, 1964, by *C. J. Jandus*