


T.22S. R.9W. W.M.

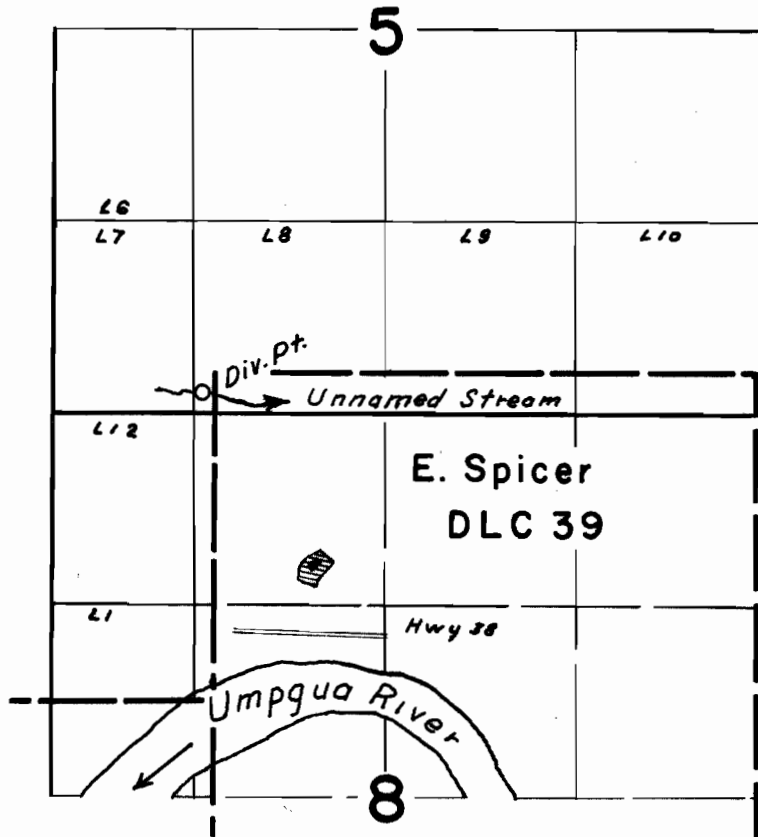

FINAL PROOF SURVEY
UNDER

Application No. 38982 Permit No. 29042
IN NAME OF

MRS. MAY LOWE

Surveyed Aug. 7, 1964, by C.J. Gardner