


T.29S. R.5W. W.M.

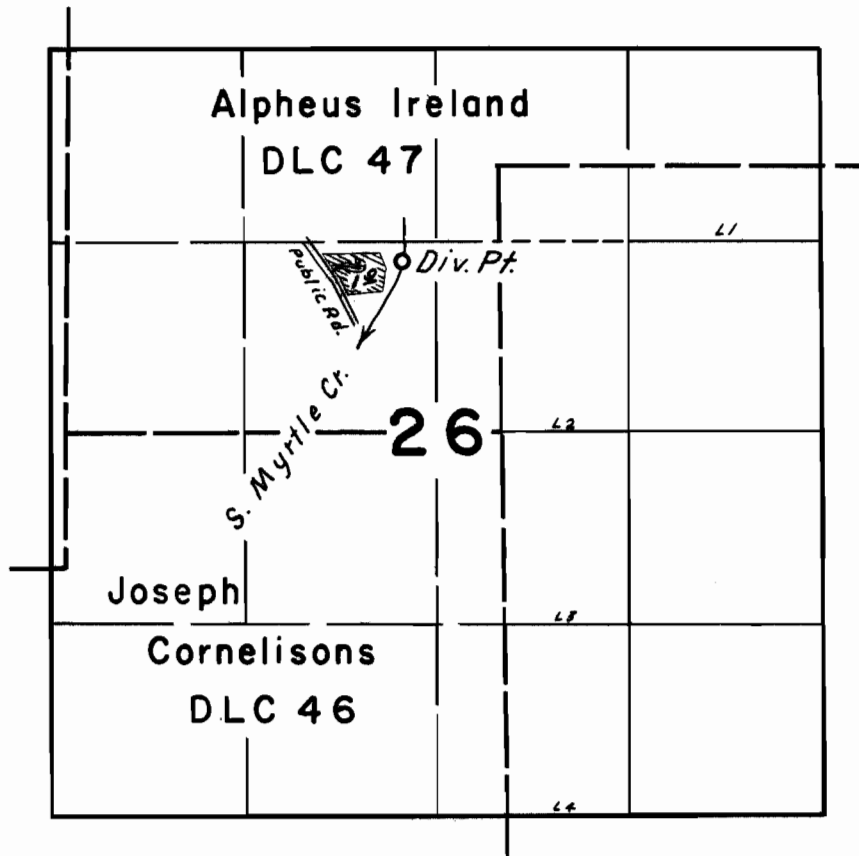

FINAL PROOF SURVEY
UNDER

Application No. 39024 Permit No. 29069
IN NAME OF

HARLEY D. and/or MARGARET L. NAAS

Surveyed Aug. 4, 1964, by *C. J. Gardner*