


T.28S. R.6W. W.M.

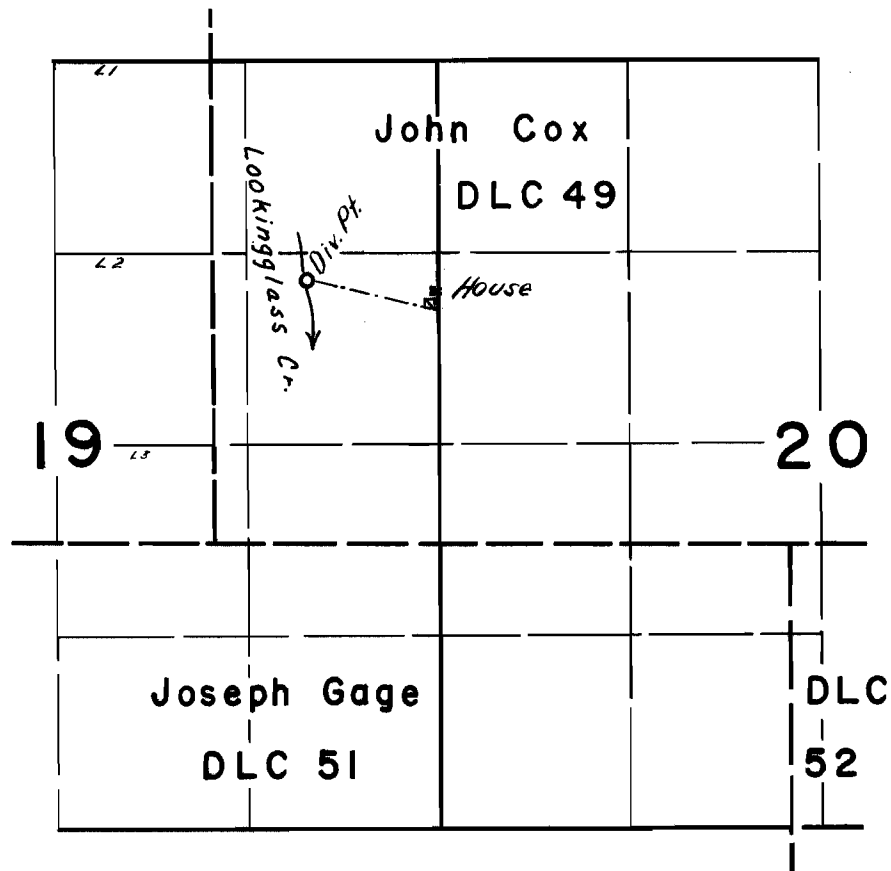

FINAL PROOF SURVEY
UNDER

Application No. 39074 Permit No. 29095
IN NAME OF

HAROLD EMERT

Surveyed July 30, 1964 by *C. J. Gardner*