


T.38S.R.3W.W.M.

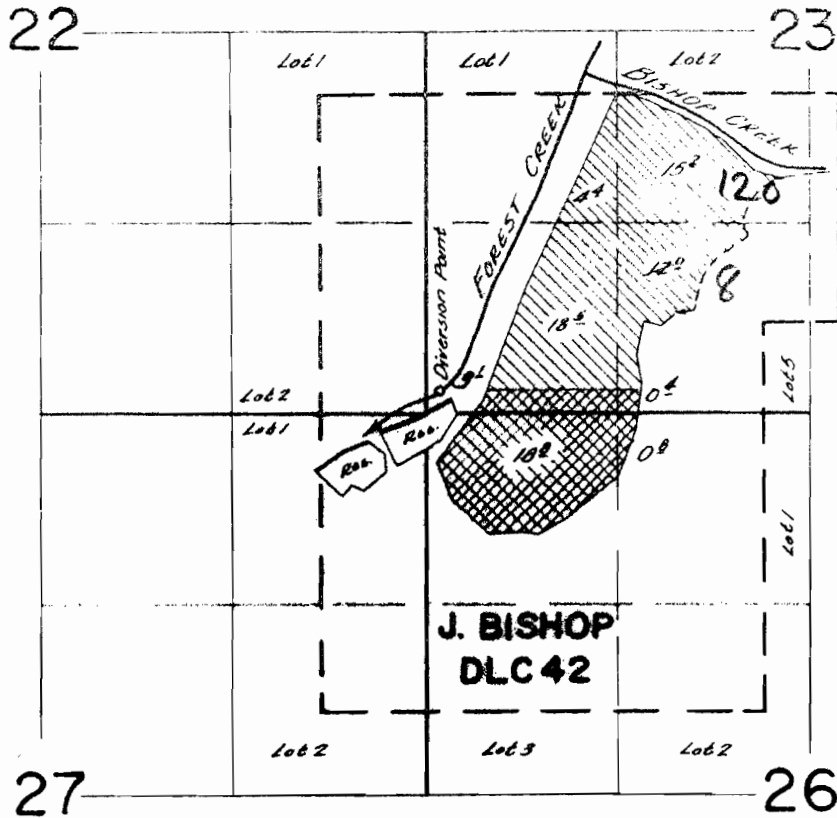

 Primary       Supplemental

**FINAL PROOF SURVEY**  
UNDER

Application No. **R-34097**      Permit No. **R-2370**  
**34098**      **26859**  
IN NAME OF

**Apilegate Investment Co.**

Surveyed June 8, 1963, by C. Baker