


T. 38S. R. 3W. W.M.

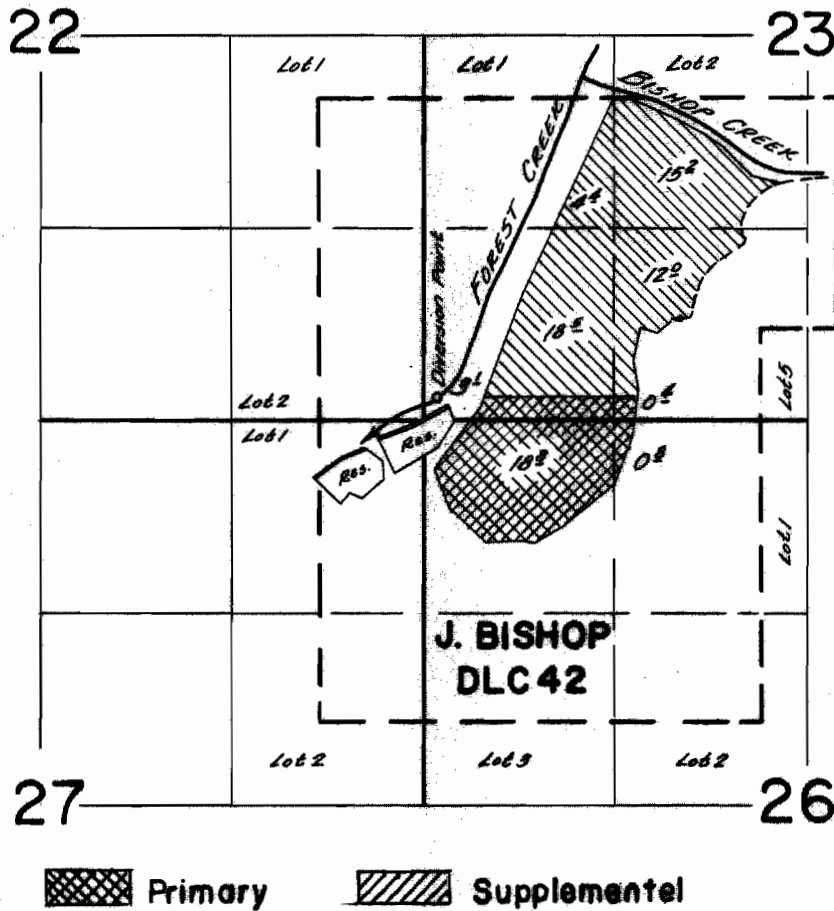

FINAL PROOF SURVEY
UNDER

Application No. R-34097 34098 Permit No. R-2370 26859
IN NAME OF

Applegate Investment Co.

Surveyed June 8, 1963, by C. Baker