


T.39S. R.18E. W.M.

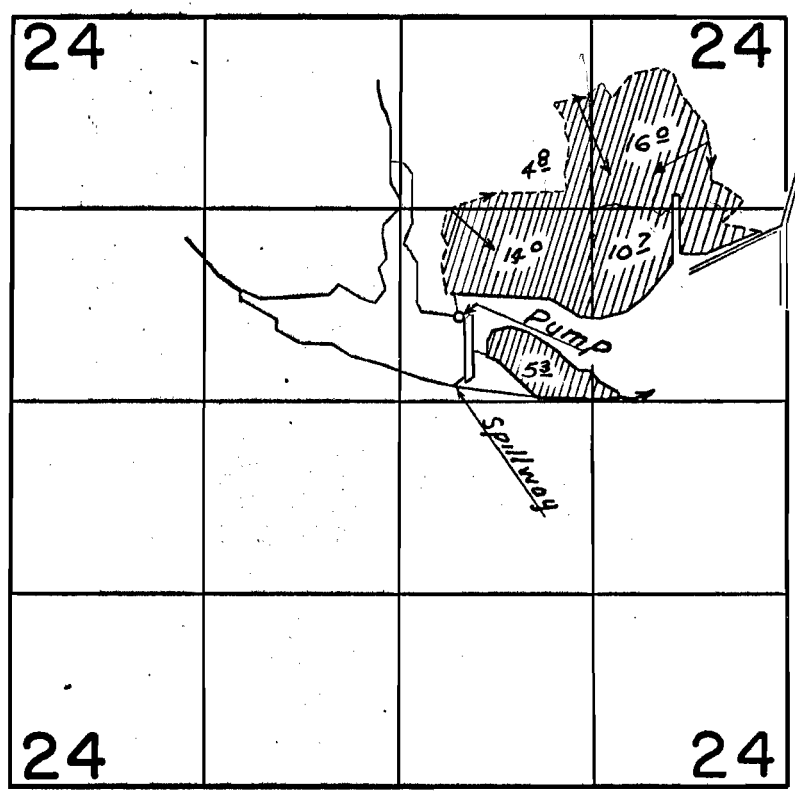

FINAL PROOF SURVEY
UNDER

R-33553 R-2316
Application No. 33554 Permit No. 26532
IN NAME OF

ANDY O. HILL

Surveyed Sept. 15, 1964, by C.J. Gardner

39-18 NA ✓