


27671
32561

T.40S.R.22E.W.M.

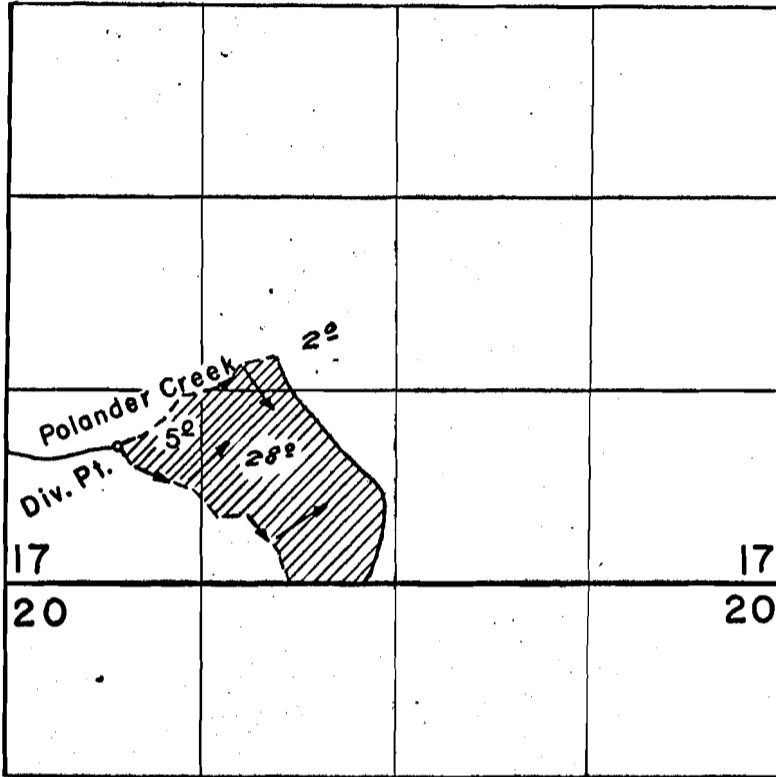

FINAL PROOF SURVEY UNDER

Application No. 37146... Permit No. 27671...
IN NAME OF

.....B.C. Robinson.....

Surveyed Sept. 16, 1964, by C.J. Gardner...

40-22

1964-0