


T.17S. R.1E.W.M.

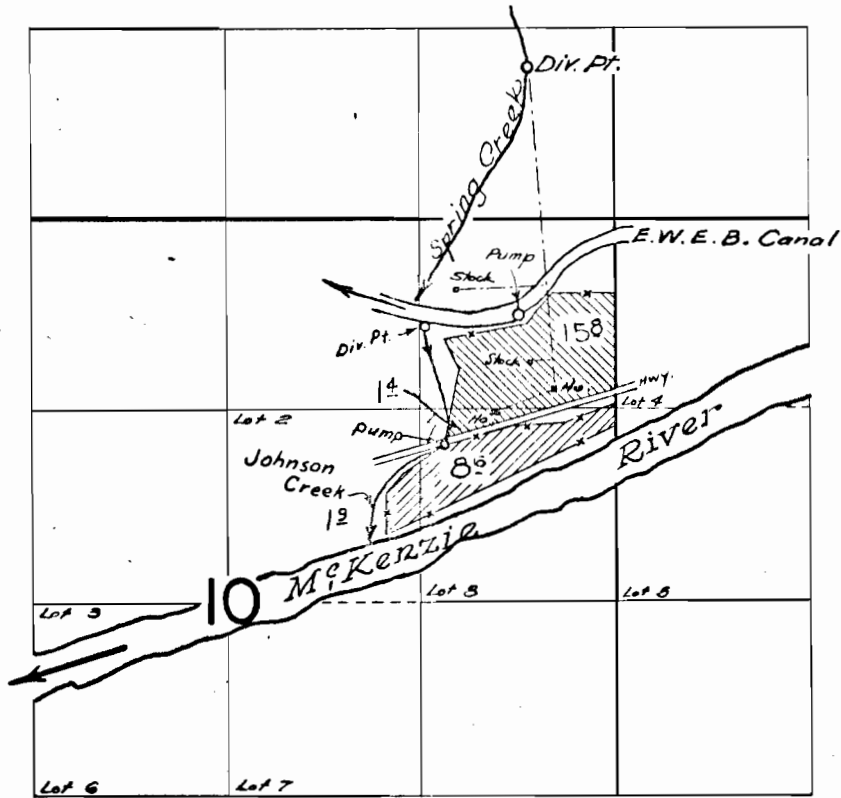

37500 
 37502 

FINAL PROOF SURVEY UNDER

Application No. 37500 ... 27948
 37501 ... 27949
 37502 ... Permit No. 27950..
 IN NAME OF

DELIA B. BAXTER

Surveyed May 9 1963, by C. Baker