


T.14S.R.2W.W.M.

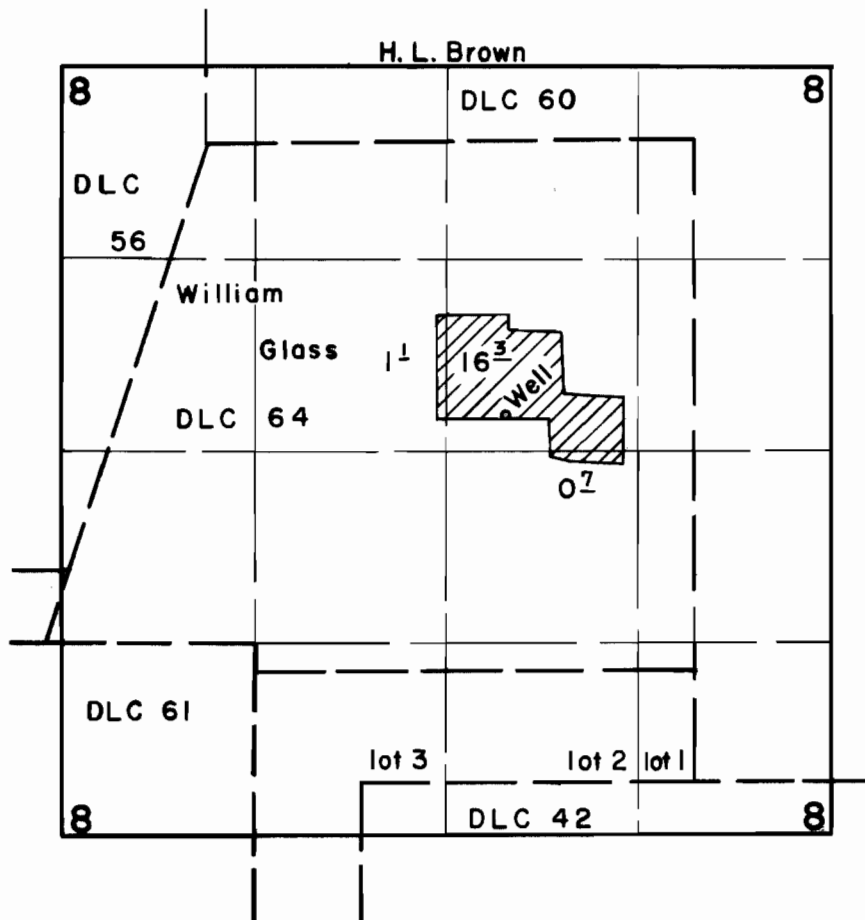

FINAL PROOF SURVEY
UNDER

Application No. G-1073... Permit No. G-940...
IN NAME OF

.....Emery C. & Jessie O. Nye.....

Surveyed May 29 1963, by Carl Baker.....