


T.14S.R.4W.W.M.

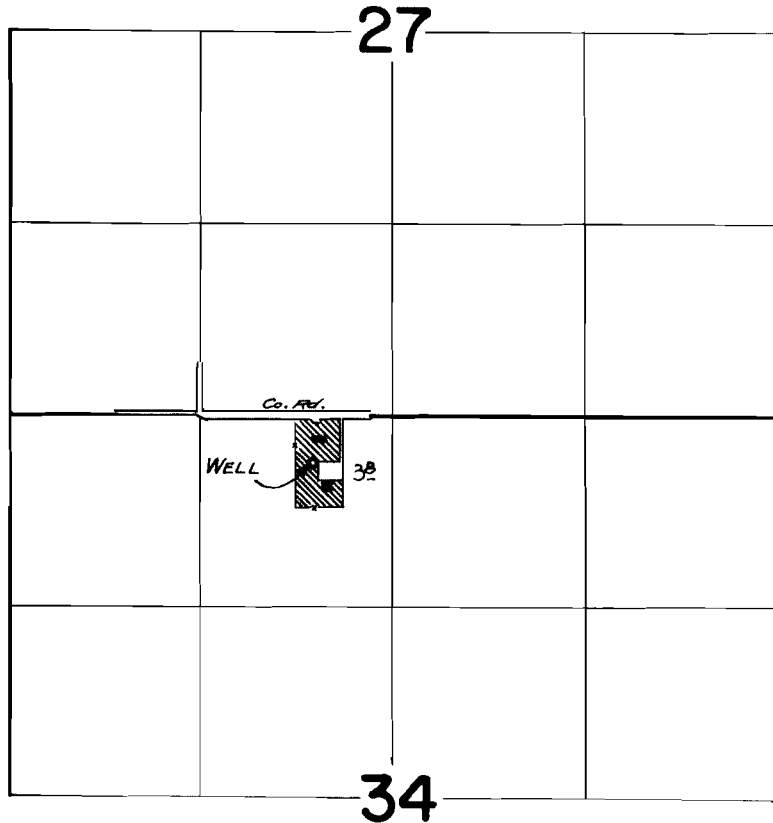

FINAL PROOF SURVEY
UNDER

Application No. G-1967 Permit No. G-1891
IN NAME OF

GERALD K. FALK

Surveyed October 14 1964, by *Alphason*