


T.9S.R.2W.W.M

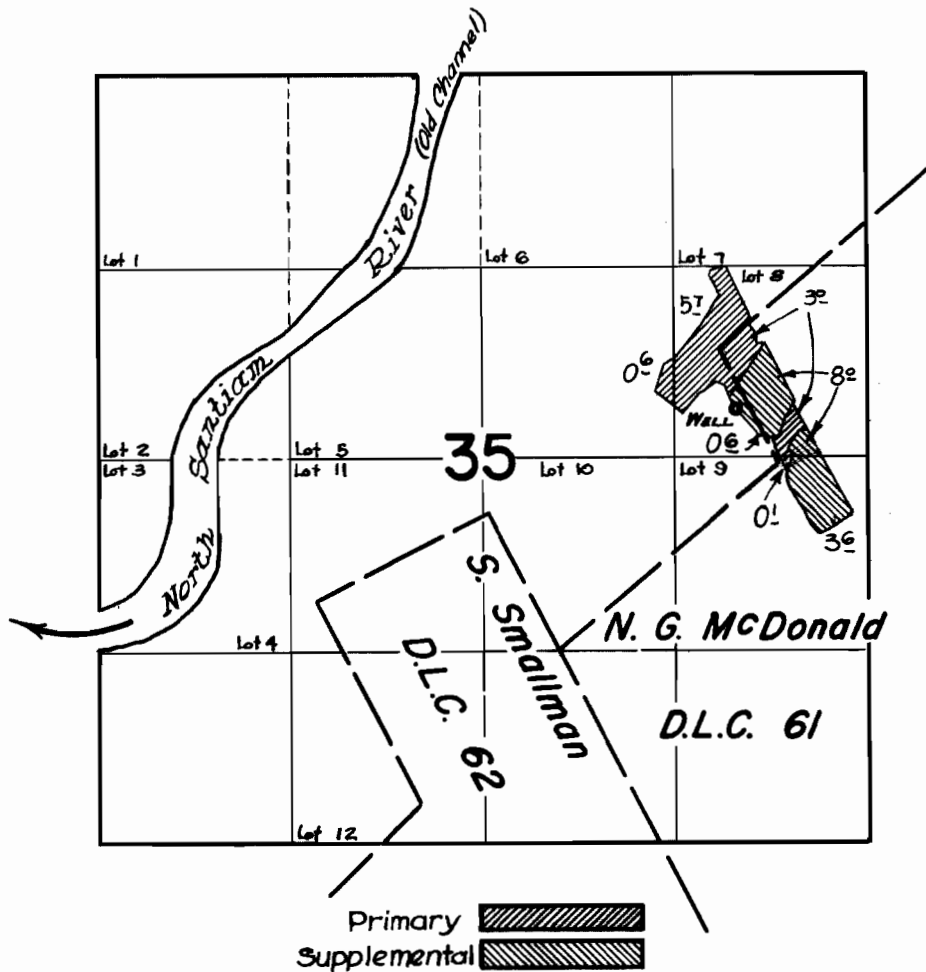

FINAL PROOF SURVEY UNDER

Application No. G-2421. Permit No. G-2235.
IN NAME OF

DAVID OGLE

Surveyed April 28 1964, by *Chapman*