


# T.9S.R.IW.W.M.

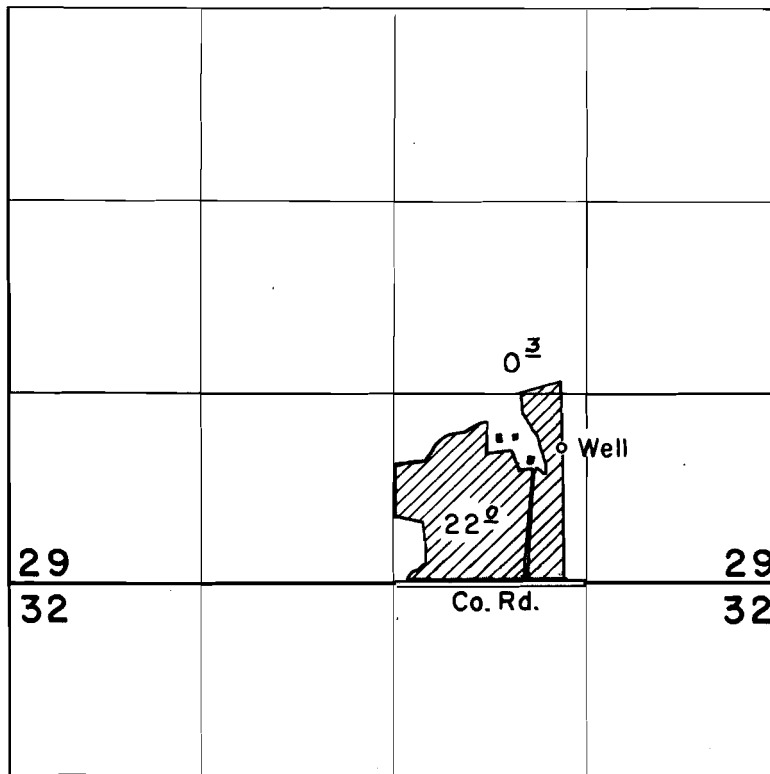

## FINAL PROOF SURVEY UNDER

Application No. G-2903 Permit No. G-2685  
IN NAME OF

Floyd E. & Mandena Becker

Surveyed Oct. 30. 1964, by E. Siegmund