


T.14S.R.18&2W.W.M.

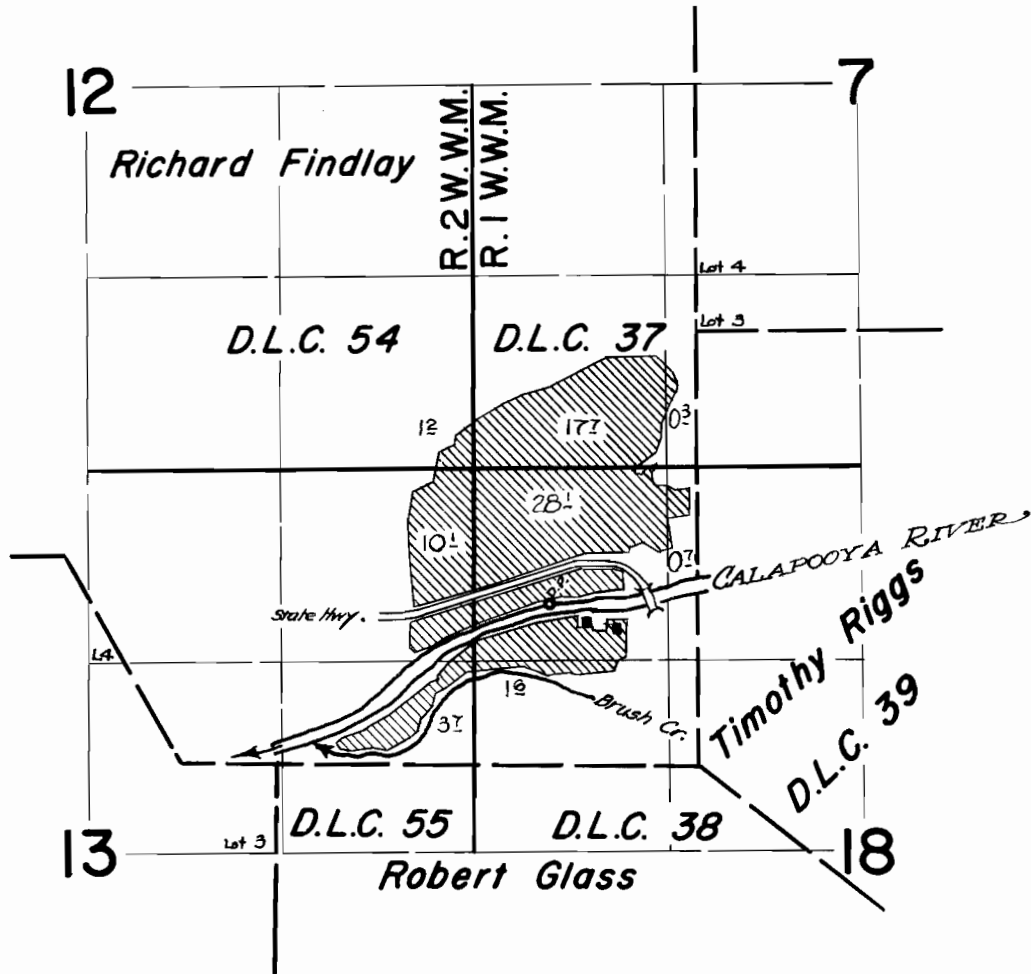

FINAL PROOF SURVEY
UNDER

Application No. 34466.. Permit No. 27070..
IN NAME OF

MERLE M. BECKER

Surveyed October 14 1964., by *L. Jackson*