


T.11S. R.4W. W.M.

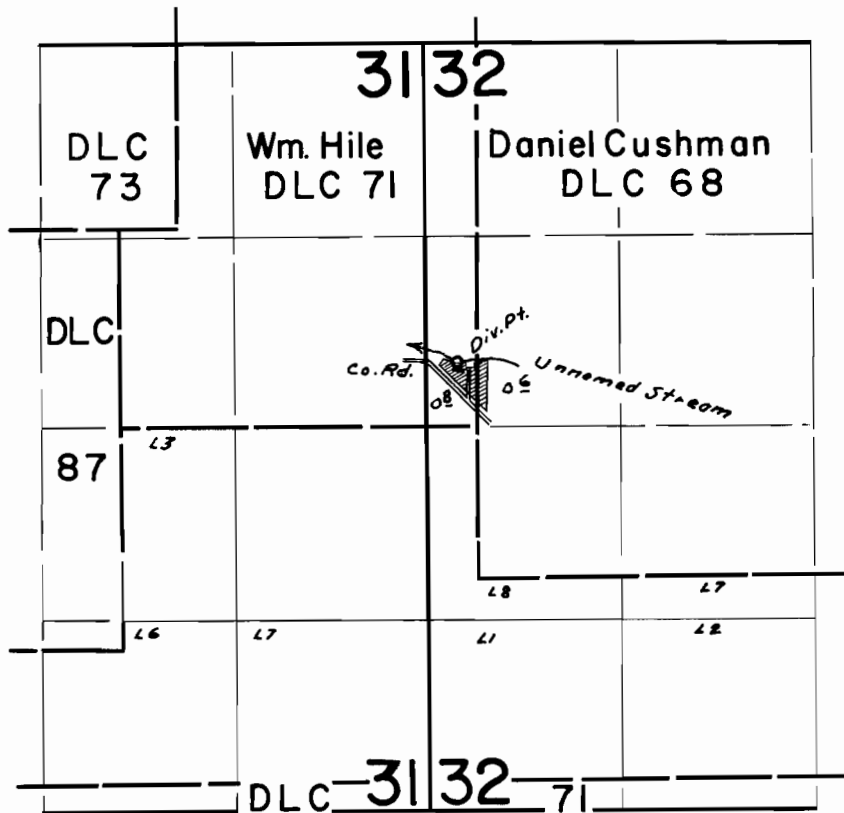

FINAL PROOF SURVEY UNDER

Application No. 37911 Permit No. 28242
IN NAME OF

JOHN C. & SHIRLEY P. RAWLINSON

Surveyed Sept. 25, 1964, by C.J. Gardner