


T.10S.R.3W.W.M.

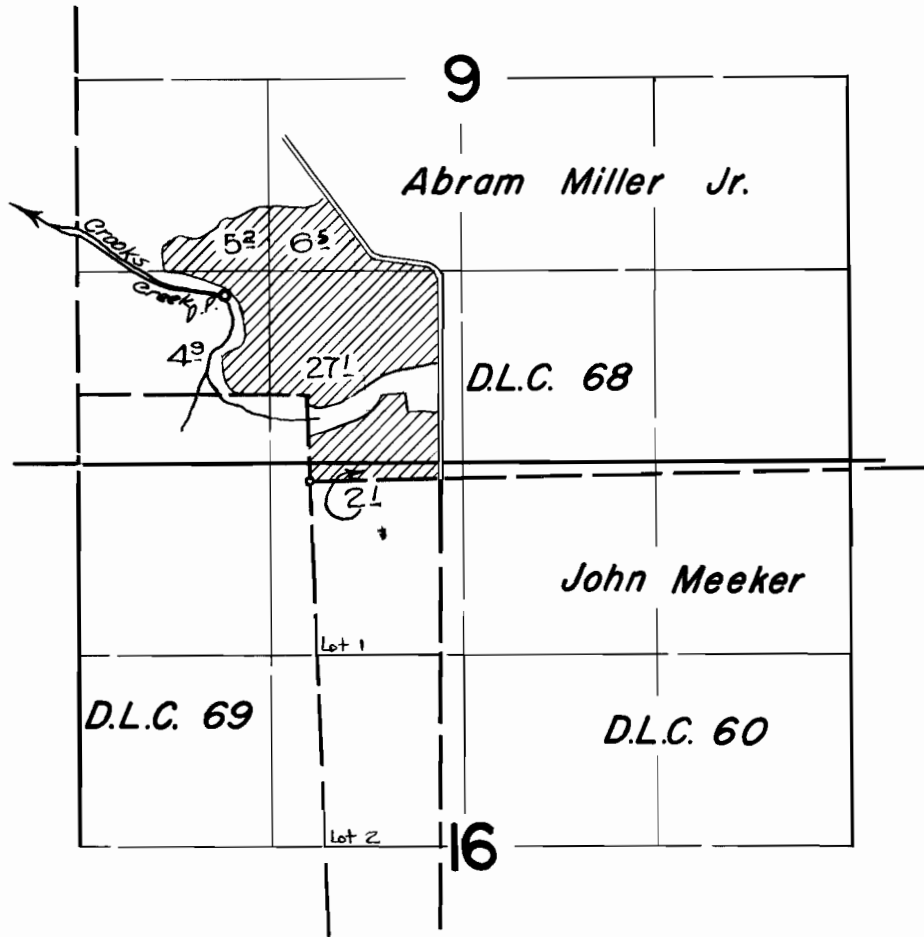


**FINAL PROOF SURVEY**  
UNDER

Application No. 38281... Permit No. 28515...  
IN NAME OF

J. D. SITTON

Surveyed May 1, 1964, by *J. Jackson*

T.10S. R.3W. W.M.

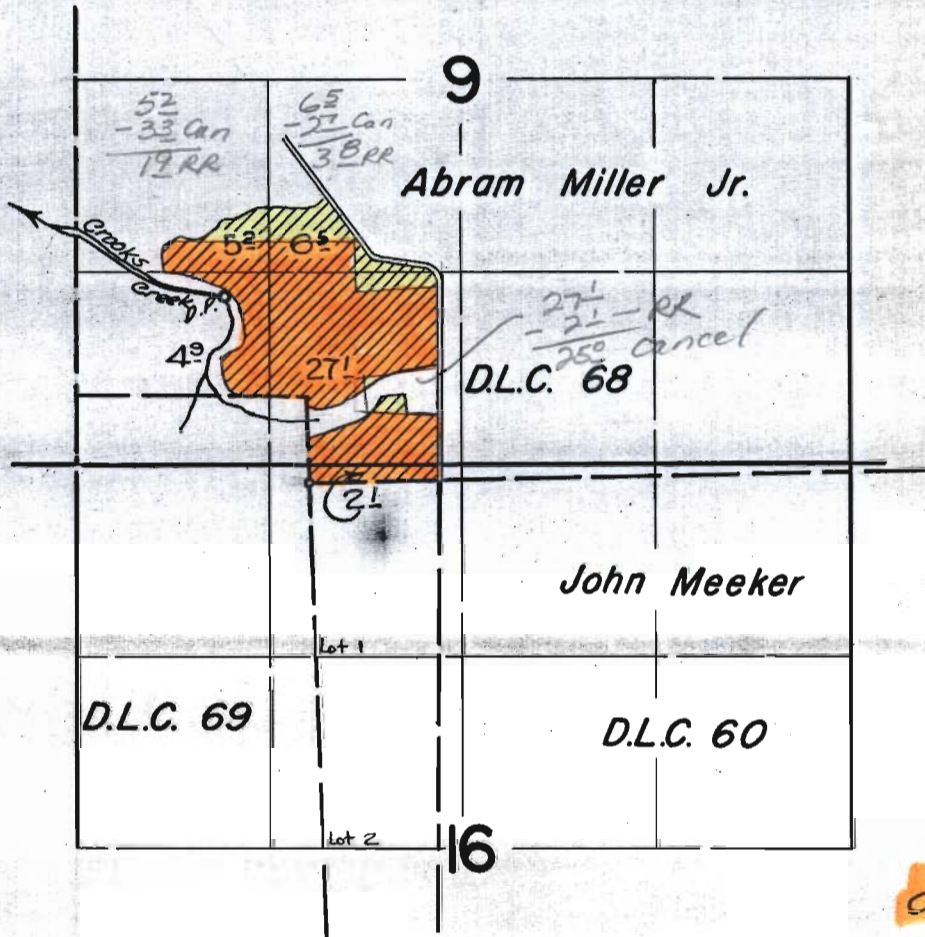

	3.3
	2.7
<b>cancel</b>	4.1
	25.0
	2.1
	<hr/>
	37.2
<b>Remaining rights</b>	1.9
	3.8
	2.1
	<hr/>
	7.8
	<hr/>
	45.0

**FINAL PROOF SURVEY**  
UNDER

Application No. 38281... Permit No. 28515...  
IN NAME OF

J. D. SITTON

Surveyed May 1, 1964, by *Jackson*