


SEC 32, T. 13 S., R. 2W., WM
SCALE: 1" = 3 CH

NE Cor D&C #1
Found Stone 4x3x17 CS on SE face

Application No. 39392
Permit No. 29360

Section 31
Section 32

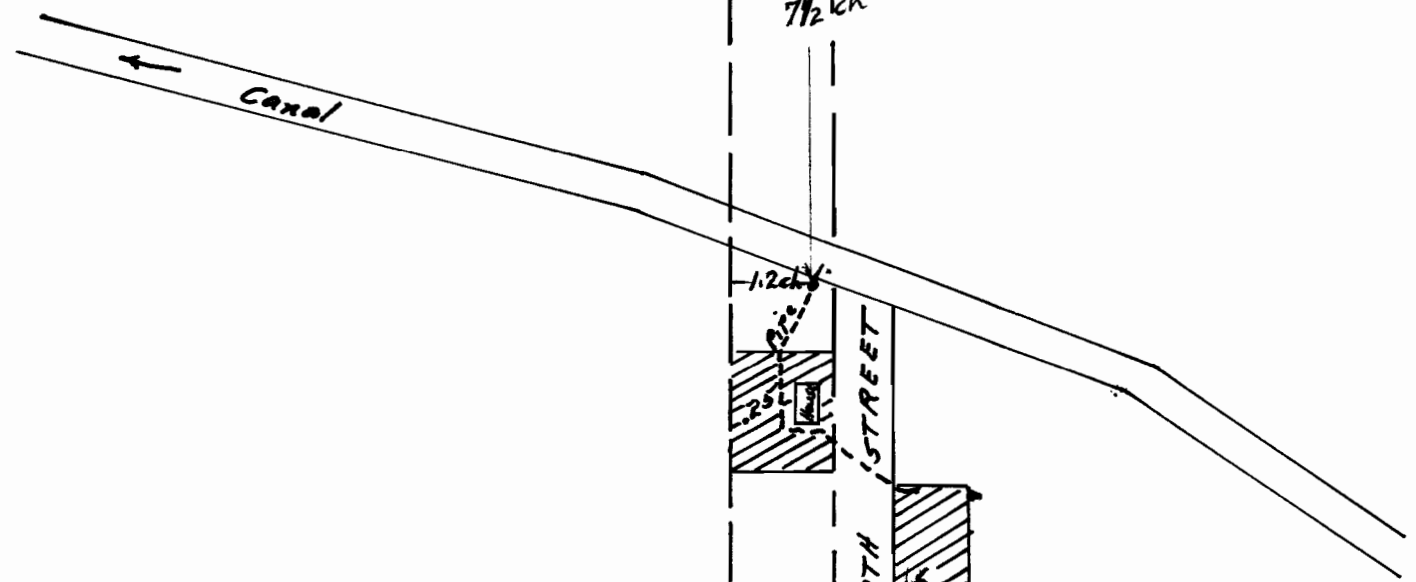

7 1/2 ch

1.2 ch

NORTH STREET

NW 1/4 SW 1/4

CENTER STREET

NE 1/4 SW 1/4

SW 1/4 SW 1/4

SE 1/4 SW 1/4

15