


T.19S. R.42 E.W.M.

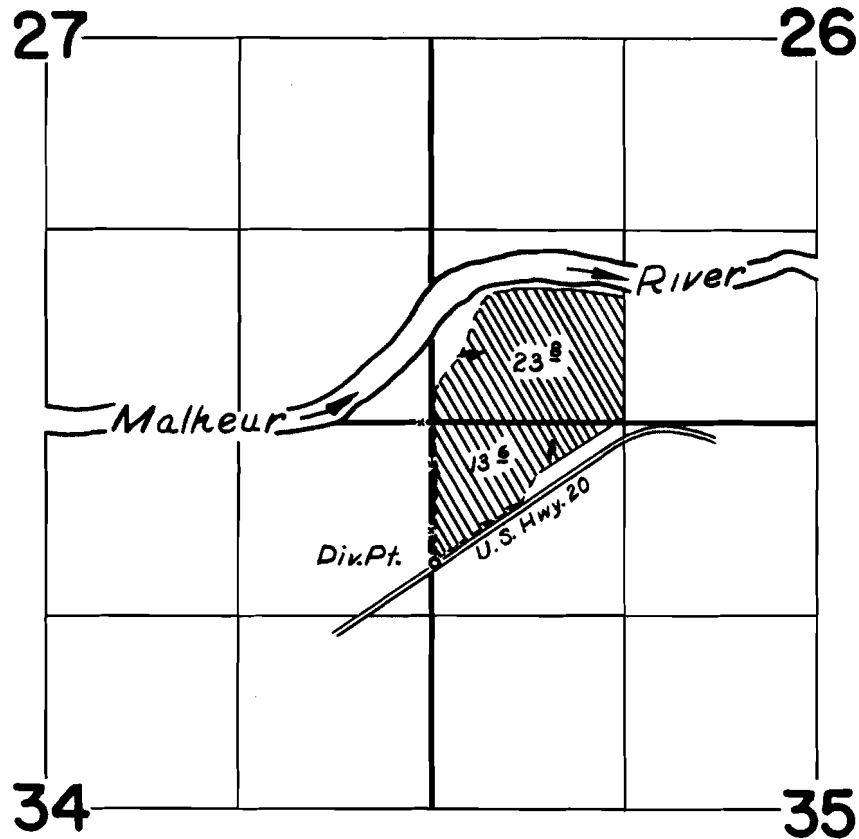

FINAL PROOF SURVEY
UNDER

Application No. 32529 Permit No. 25988
IN NAME OF

JOHN E. O'TOOLE

Surveyed June 8 1962, by C.R. Baker