


T. 20 S.R. 46 E.W.M.

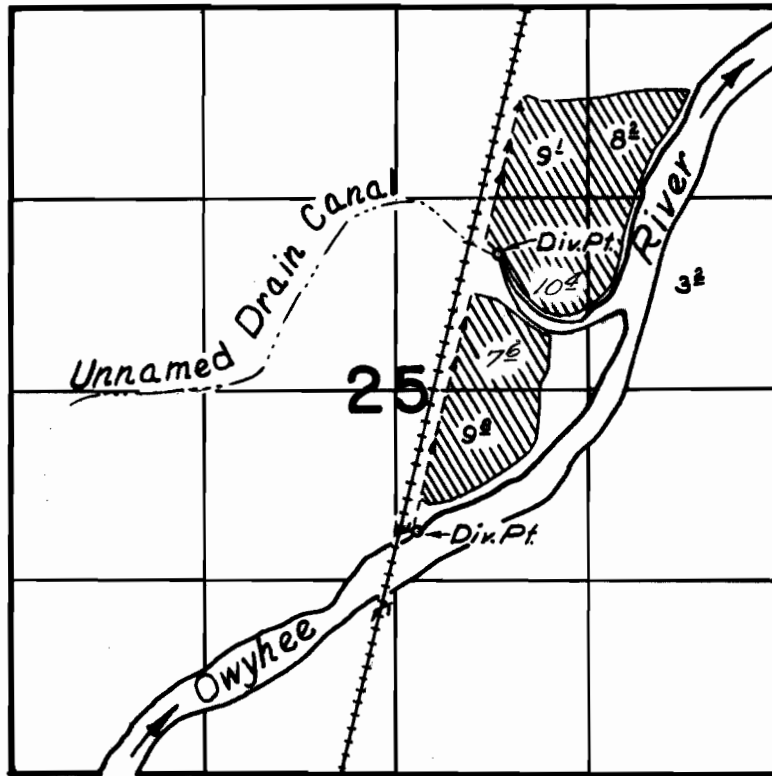

FINAL PROOF SURVEY
UNDER

Application No. 33/25... Permit No. 26274...
IN NAME OF

.....**KENNETH R. PICKETT**.....

Surveyed *June 7* 1962, by *C.R. Baker*.....