


T. 5 S. R. 1 W. W. M.

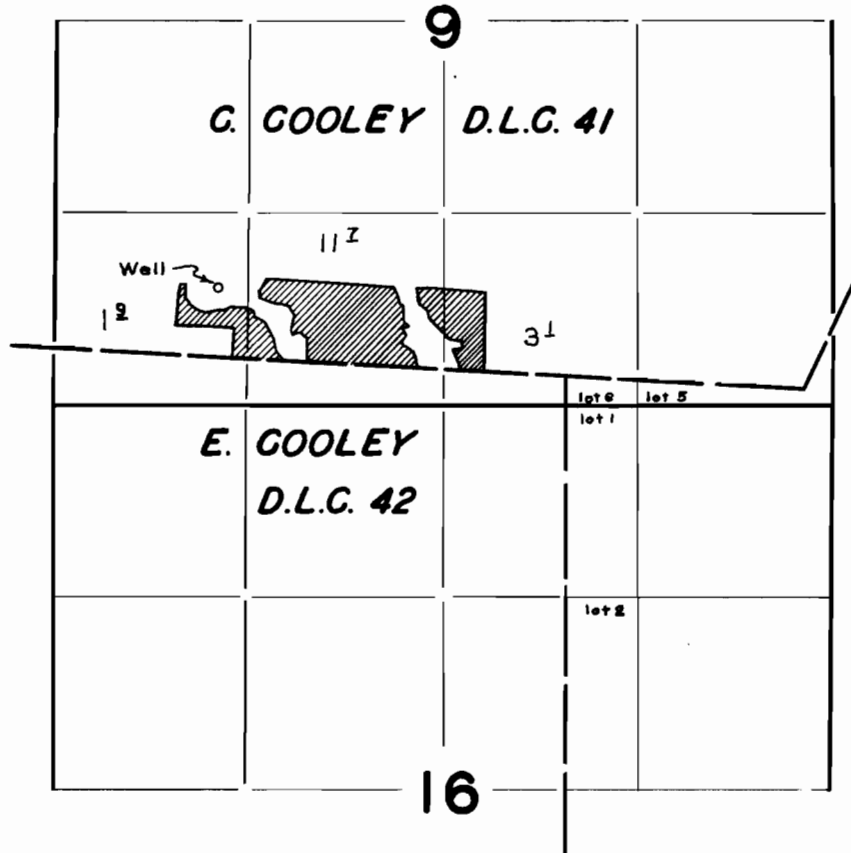

FINAL PROOF SURVEY
UNDER

Application No. G-2147 Permit No. G-1990
IN NAME OF

T. A. STEELE

Surveyed Aug. 4 1964, by R. JACKSON